IREDELL COUNTY HEALTH DEPARTMENT - *ENVIRONMENTAL HEALTH* ☐ STATESVILLE OFFICE 704-878-5305 ☑ MOORESVILLE OFFICE 704-664-5281

3:30 4m,

IMPROVEMENT PERMIT / AUTHORIZATION TO CONSTRUCT / OPERATION PERMIT / EXISTING SYSTEM INSPECTION

PERMIT # 17J081 PIN # 4659-70-0861 DATE 3-19-12

OWNER BOBBY BRAWLEY APPLICANT: SAME PHONE: Home/Cell # 704-664-5153 Business #

SITE ADDRESS 1784 CHARLOTTE HWY 28115 OWNER / APPLICANT ADDRESS 985 HAMPTON PL. 28115

SITE DIRECTIONS HWY 21, ON L JUST BEFORE SHEPHERD SCHOOL

SUBDIVISION BLOCK / SECTION LOT # LOT AREA 1.48 AC DESIGN FLOW 360 L.T.A.R. 3

Septic Tank 1000 Gallons: STB 794 Date 4-15-12

Pump Tank Gallons: P T Date

Pump Make Model Serial #

No. Nitrification Fields: 1 No. Lines 5 Linear Feet 300'

Trench Width 36" Max. Trench Bottom Depth 24"

☑ New System ☐ Repair ☐ Expansion System Type I II (III) IV V VI

System Description: GRAVITY 25%

Repair System Description: SAME

Maintenance Agreement Required ☐ YES ☑ NO

☑ GRAVITY ☐ PRESSURE

☑ Residence No. Bedrooms 3

☐ Business No. Persons

☐ Other No. Employees

☐ Slab ☑ Crawl Space


☐ Basement w/plumbing ☐ Basement w/o plumbing

Water Supply: ☑ Private ☐ Public ☐ Community


Comments / Conditions (1) 24" TRENCH BOTTOM (2) STAY AS FAR AS POSSIBLE FROM MAPLE TREE.

7/27/12 Checked ST & lines used ADS 36 with Distribution Box Put Speed Levelers in lower 2 lines

INITIAL SITE SKETCH

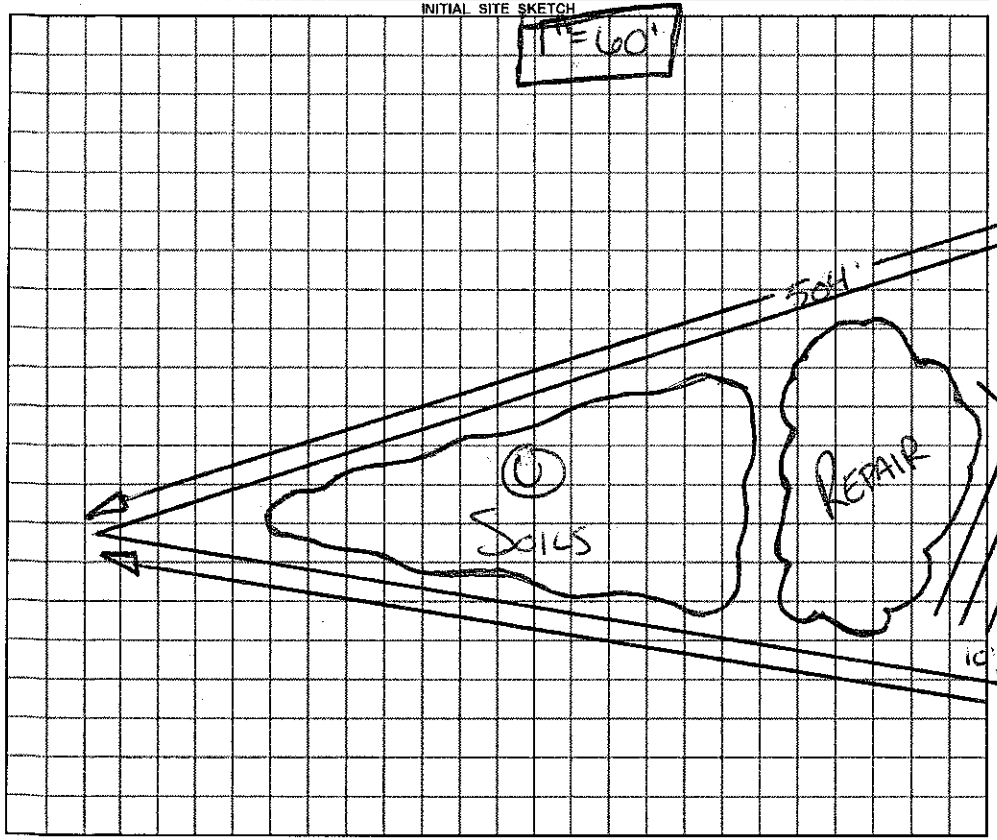

AS BUILT SKETCH

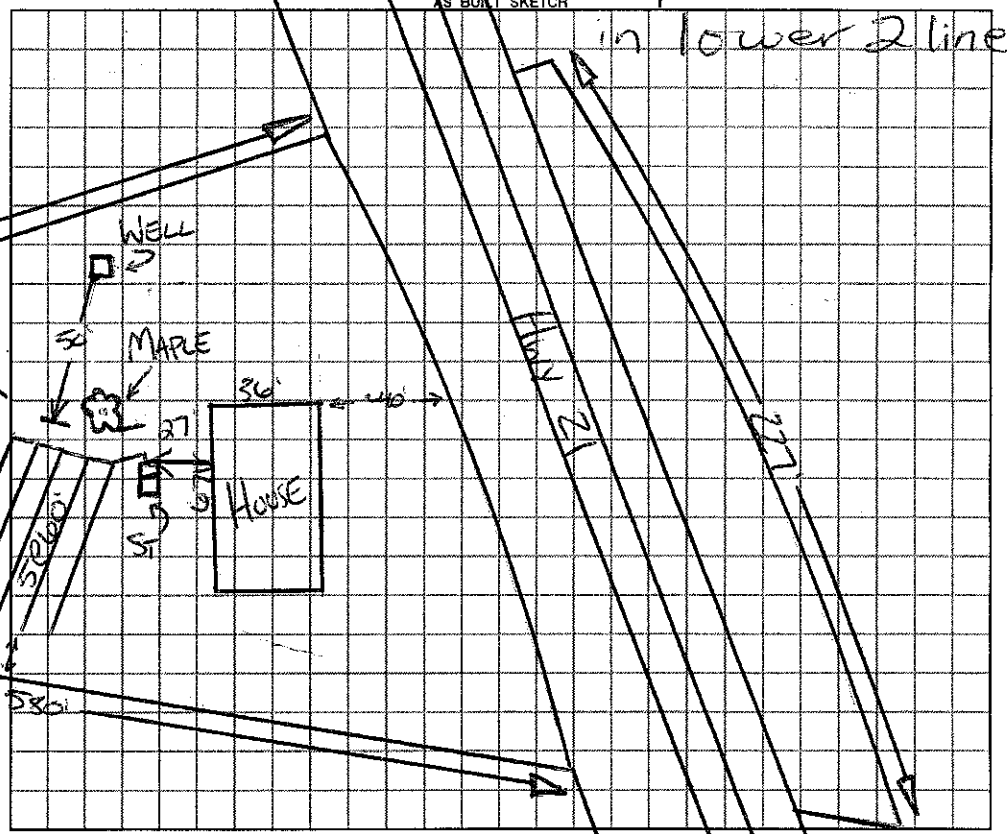

Permit can be suspended or revoked if any false information is supplied toward securing the permit / any unauthorized changes are made to the site / any unauthorized changes are made in the installation of the system.

☐ ***IMPROVEMENT PERMIT*** with plat valid without expiration. ☑ ***IMPROVEMENT PERMIT*** with plat valid without expiration. ~~site plan valid 60 mo.~~ ☐ ***AUTHORIZATION TO CONSTRUCT*** valid for period equal to IMPROVEMENT PERMIT not to exceed 60 mo.

Owner / Applicant Signature: Bobby Brawley Date 3-20-12

IMPROVEMENT PERMIT by: REHS Date 3-19-12

AUTHORIZATION TO CONSTRUCT by: REHS Date 3-20-12

YOU SHOULD CONTACT A LOCATOR SERVICE PRIOR TO ANY EXCAVATION

Installed by: Brad Warren

OPERATION PERMIT by: REHS Date 7/26/12

Existing System Inspected by: REHS Date

White Copy – Environmental Health YELLOW COPY (Final) Owner / Applicant PINK COPY (Initial) Owner / Applicant