IREDELL COUNTY HEALTH DEPARTMENT

4659700861

STATESVILLE 704-878-5305 (664-6504) MOORESVILLE 704-664-5281 (664-6506)

IMPROVEMENT PERMIT / CERTIFICATE OF COMPLETION / OPERATION PERMIT / EXISTING SYSTEM INSPECTION

PROPERTY DESCRIPTION NO. Repair DATE 7/9/96 TAX MAP NO. Repair Watershed: ☐ Yes ☐ No

OWNER OR CONTRACTOR Bobby Brawley PHONE: Business 664-2838 Home 664-5153

ADDRESS 1756 Charlotte Hwy

LOCATION 21N - House beside shepherd school

SUBDIVISION _____ BLOCK / SECTION _____ LOT _____ LOT AREA _____ SITE CLASS. _____ DESIGN FLOW 2 X 0gpd L.T.A.R. 2.3

Septic Tank: existing Gallons; STB _____ Date _____

Pump Tank: _____ Gallons; PT _____ Date _____

Pump Make: _____ Model _____ Serial No. _____

Nitrification Field: No Fields ____ Square Feet _____ Linear Feet _____

No Lines _____ Trench Width _____ Max Trench Bottom Depth _____ Gravel Depth _____

☐ New System ☑ Repair System Type: I. II. III. IV. V. VI

System Description: _____

Repair System Description: gravity conv.

Maintenance Agreement Required: ☐ Yes ☐ No

☑ House/Mod. Home No. Bedrooms 2

☐ Mobile Home No. Bathrooms 2

☐ Business No. Employees ____

☐ Other _____


☐ Slab ☐ Crawl Space ☐ Basement w/plumbing ☐ Basement wo/plumbing

Water Supply:
☑ Individual
☐ Community
☐ Public


Comments: * Dig Distribution box up to see if future lines need to be added. Health Dept needs to see distribution box. *

Comments:

INITIAL SITE SKETCH

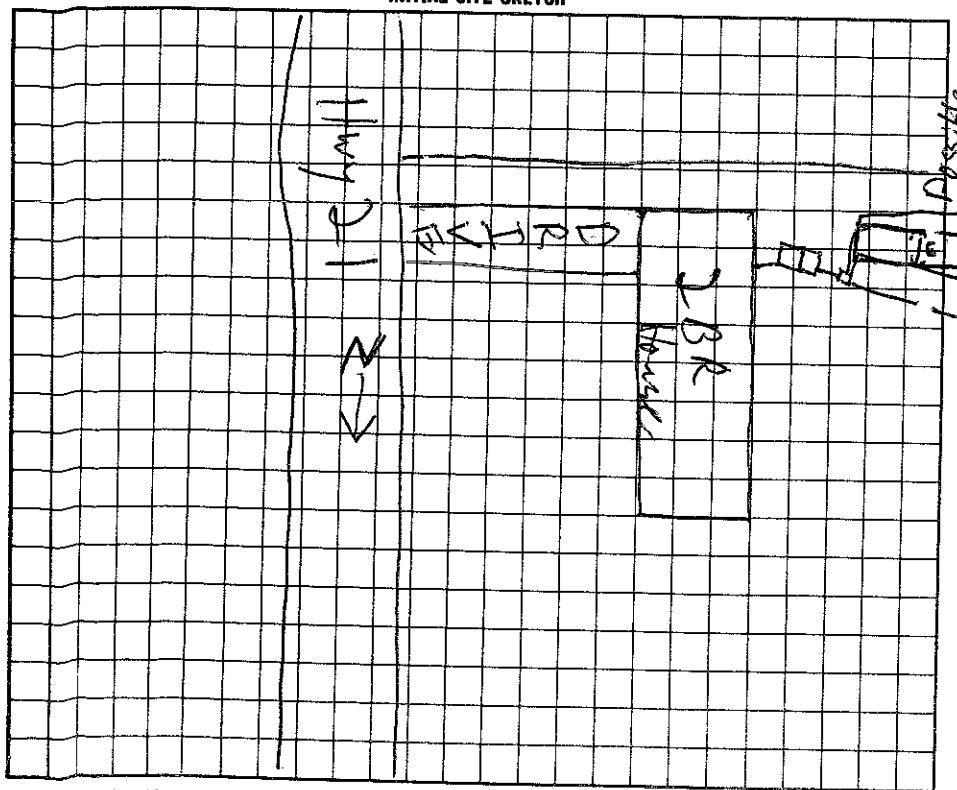

AS BUILT SKETCH

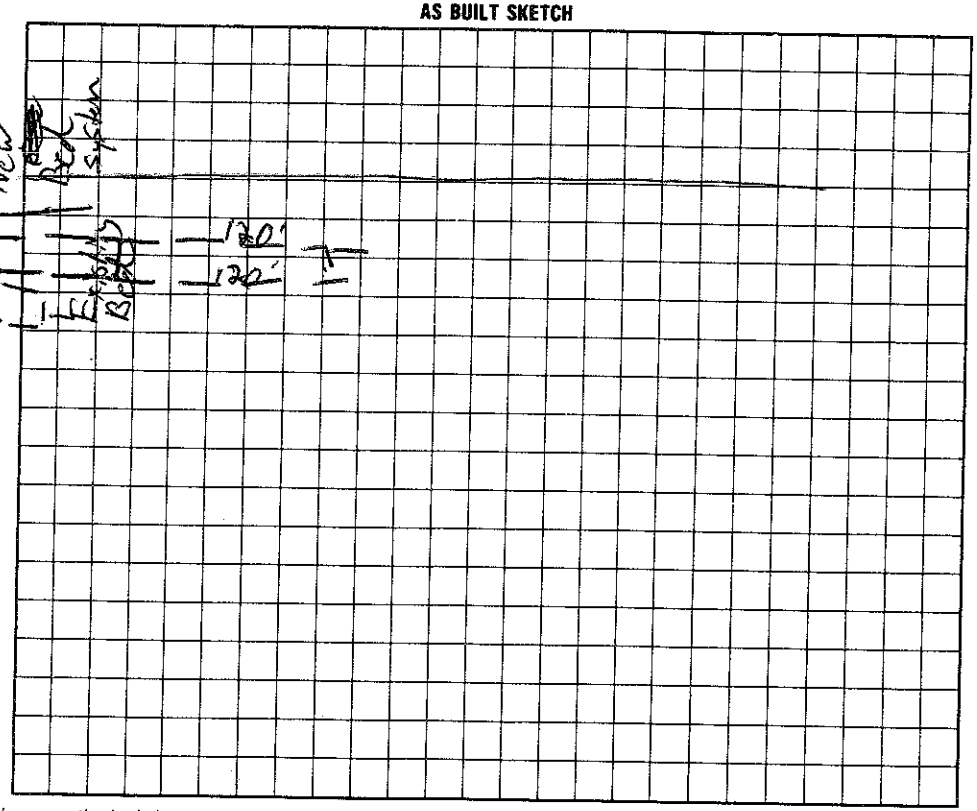

I understand that this permit can be suspended or revoked if any false information is supplied toward securing the permit/any unauthorized changes are made to the site/any unauthorized changes are made in the installation of the system.

Signed: _____

Improvement Permit by: C. Ricky Freeman date 7/9/96

Existing System Inspection by: C. Ricky Freeman date 7/9/96

Installed by: Richard Abernathy

Certificate of Completion by: _____ date _____

Operation Permit by: C. Ricky Freeman EHSF date 7/19/96

HEALTH DEPT. COPY: WHITE INSPECTION COPY (FINAL): GREEN OWNER COPY (FINAL): YELLOW INSPECTION COPY (INITIAL): PINK OWNER COPY (INITIAL): GOLD