IREDELL COUNTY HEALTH DEPARTMENT

Authorization to Construct

STATESVILLE 704-878-5305 MOORESVILLE 704-664-5281

IMPROVEMENT PERMIT / ~~CERTIFICATE OF COMPLETION~~ / OPERATION PERMIT / EXISTING SYSTEM INSPECTION

PROPERTY DESCRIPTION NO. Reppin DATE 5/10/96 TAX MAP NO. N/A 4659-70-1108 Watershed: ☐ Yes ☒ No

OWNER OR CONTRACTOR Peter Pedwell PHONE: Business 464-3772 Home

ADDRESS 123 Peace Ln. Mooresville NC. 28115 131 Peace Ln.

LOCATION 21-115 N To Peace Ln then (L) to end of driveway

SUBDIVISION BLOCK / SECTION LOT LOT AREA SITE CLASS. DESIGN FLOW L.T.A.R.

Septic Tank: Envirotay Gallons; STB Date

Pump Tank: 1000 Gallons; PT 49 Date 6/12/96

Pump Make: HYDROTEK Model LE61A Serial No. 703

Nitrification Field: No Fields Square Feet Linear Feet

No Lines Trench Width Max Trench Bottom Depth Gravel Depth

☐ New System ☒ Repair System Type: I, II, (III), IV, V, VI

System Description:

Repair System Description:

Maintenance Agreement Required: ☐ Yes ☒ No

☒ House/Mod. Home No. Bedrooms 3

☐ Mobile Home No. Bathrooms 2

☐ Business No. Employees

☐ Other


☐ Slab ☐ Crawl Space ☐ Basement w/plumbing ☐ Basement wo/plumbing

Water Supply: ☒ Individual ☐ Community ☐ Public


Comments:

Comments:

INITIAL SITE SKETCH

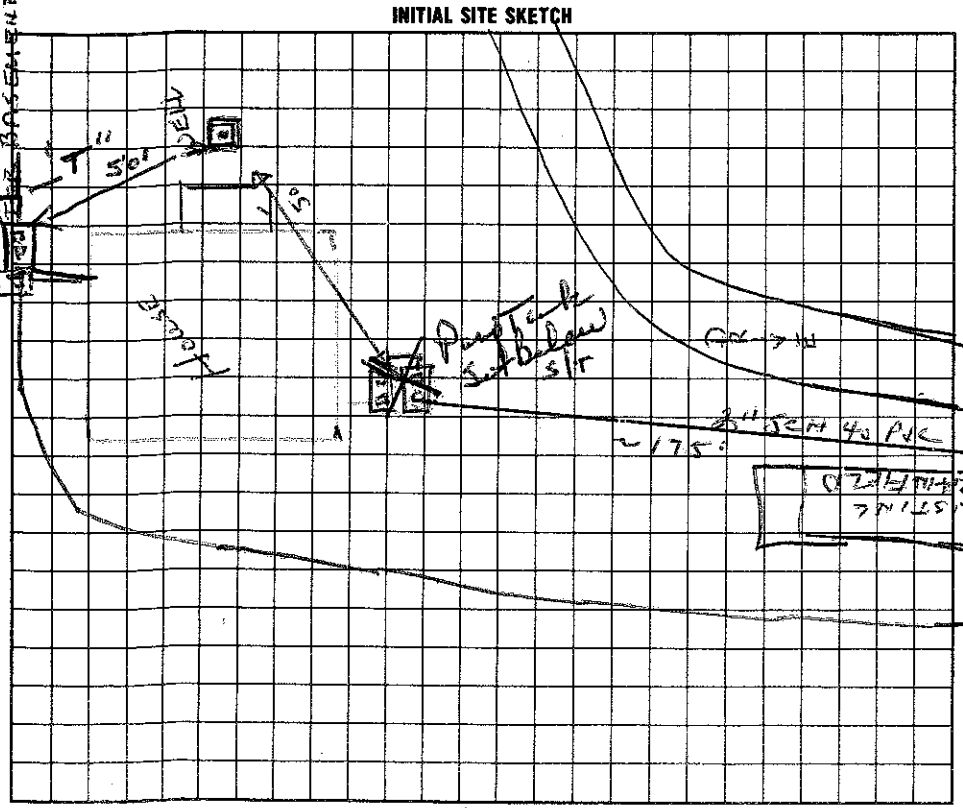

AS BUILT SKETCH

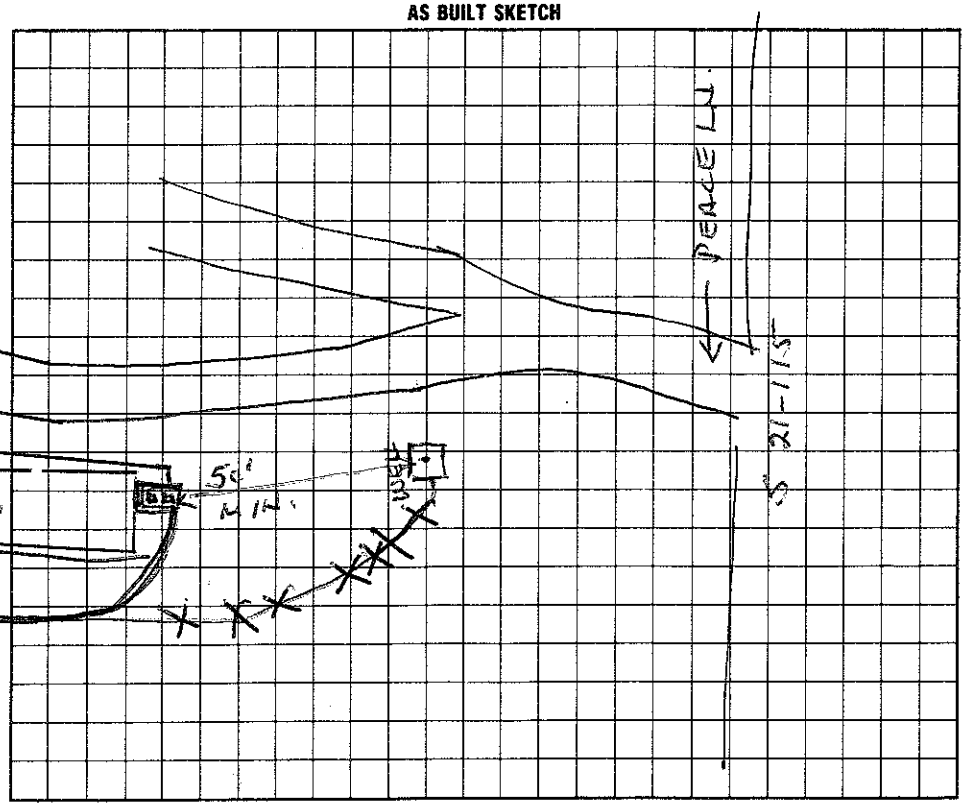

I understand that this permit can be suspended or revoked if any false information is supplied toward securing the permit/any unauthorized changes are made to the site/any unauthorized changes are made in the installation of the system.

Signed:

Installed by: Barry Seymon

Improvement Permit by: date

Authorization to Construct Wesley Sparks date 5/10/96

Certificate of Completion by: date

Existing System Inspection by: Operation Permit by: Wesley Sparks RS date 8/20/96

HEALTH DEPT. COPY: WHITE INSPECTION COPY (FINAL): GREEN OWNER COPY (FINAL): YELLOW INSPECTION COPY (INITIAL): PINK OWNER COPY (INITIAL): GOLD

№ 16338

PROPERTY DESCRIPTION

Call Sanitarian Between
8 a.m. and 9 a.m.
664-5281 / 878-5305

APPLICATION FOR- (Not a Permit) ( ) Improvements Permit (X) Zoning Permit ( ) Special Use ( ) Subdivision Approval ( ) Other

Proposed Use: To Install Bath Rooms Inside Existing

Location: 215 Court Post Shepard School Bldg.

Tax Map No.	Township	Jurisdiction	Zoning
16-B-13A	Cyclic C.	Iredell	R-A

Subdivision/Mobile Home Park	Lot No.	Lot Size	Flood Plain
		4.16	( ) yes ( ) no

Approx. Area to be disturbed	Engineering Firm	Contact	Phone	Street Address

TAX MAP NO. _____


REQUIRED INFORMATION FOR IMPROVEMENTS PERMIT - IREDELL COUNTY HEALTH DEPARTMENT

SKETCH MAP

On the lot to be built on or to be used, show the property lines and the actual dimensions of the lot, the size and shape of any and all buildings located or to be located on the lot showing the distances from lot lines. Show setback of main building on adjacent lot and their use.

H.B. 205.40

73039, Lot

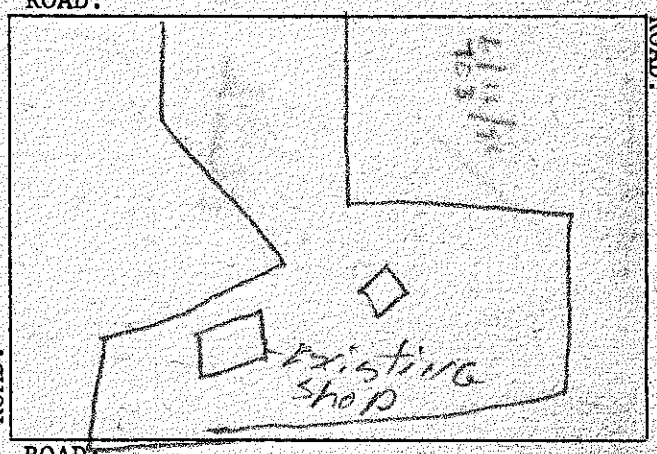

OWNER	ADDRESS	PHONE NO.
Edward Cabinet	Rt 4 Box 593, Mooresville, NC	664-3533

I certify that all of the statements made in this application and any attached documents are true, complete and correct to the best of my knowledge and belief and are made in good faith. I understand that false information may be grounds for rejection of this application. Authorized Health Department and Inspection Department Representatives are granted right of entry to make evaluations or inspections and to release information upon public request.

Peter L Redwick — 5-14-93

Signature of Owner or Authorized Agent — Application Date

If permitted, the following minimum zoning requirements must be met, unless the Health Department requires more land area or other qualifications are indicated in the remarks.

Lot area 20,000 sq. ft. Front yard depth 35 ft. Corner yard depth 25 ft.

Lot width 100 ft. Side yard depth 15 ft. Rear yard depth 35 ft.

#2285

LAND USE INDICATED (is) ~~(is not)~~ PERMITTED IN THE ZONING DISTRICT.

REMARKS: Existing Non-Conforming Business

ZONING ADMINISTRATION DIVISION

Approved by — 5-14-93 Date

WHITE: Original CANARY: Inspection Copy PINK: Health Dept. GOLD: Owner