IREDELL COUNTY HEALTH DEPARTMENT

Statesville Office (704) 878-5305 Mooresville Office (704) 660-3625 PERMIT # 181238 gm

IMPROVEMENT PERMIT / AUTHORIZATION TO CONSTRUCT / OPERATION PERMIT / EXISTING SYSTEM

PIN # 4659-70-1784

APPLICANT: Phyllis Lowrance APPLICANT ADDRESS: 1794 Charlotte Hwy Mooresville NC 28115

SITE ADDRESS: 1794 Charlotte Hwy Mooresville NC 28115 PHONE: 704-662-8616 ALT. PHONE:

SITE DIRECTIONS: Hwy 115 N (Charlotte Hwy), Before Sheppard Rd on Lt, Across from Vandenburg UMC

SUBDIVISION: SECTION: LOT # LOT AREA: 0.65ac DESIGN FLOW: EXISTING L.T.A.R.:

Septic Tank EXISTING (gal) STB Date
Pump Tank (gal) PT Date
Pump Make Model Serial #
Nitrification Fields # Lines Linear Ft:
Trench Width Max. Trench Bottom Depth Gravel Depth


☐ New System ☐ Repair ☐ Expansion System Type: I II III IV V VI
System Description: EXISTING
Repair System Description:
Maintenance Agreement Required: ☐ YES ☐ NO
☑ GRAVITY ☐ PRESSURE

☐ Residence No. Bedrooms
☐ Business No. Persons
☑ Other No. Employees
☐ Slab ☐ Crawl Space
☐ Basement w/ plumbing ☐ Basement w/o plumbing

Water Supply: ☑ Private ☐ Public ☐ Community

Comments / Conditions: * Addition of a 12'x16' Accessory Building

INITIAL SITE SKETCH

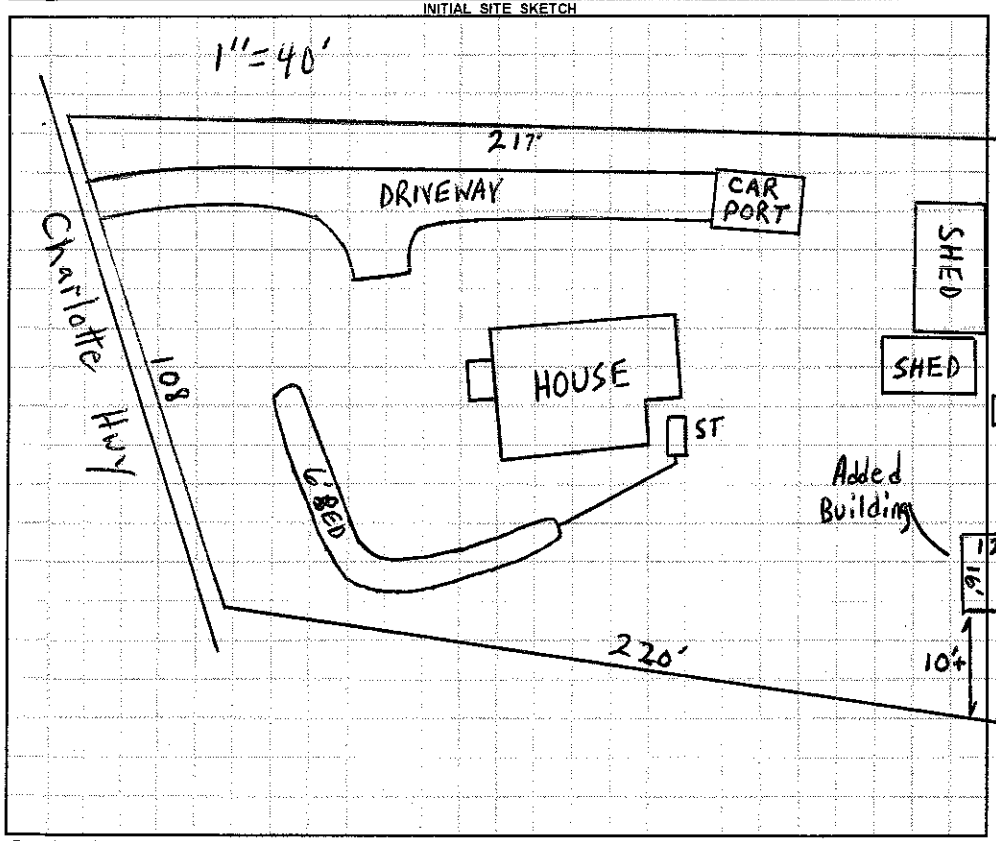

AS BUILT SKETCH

Permit can be suspended or revoked if any false information is supplied toward securing the permit / any unauthorized changes are made to the site / any unauthorized changes are made in the installation of the system. CONTACT A LOCATOR SERVICE PRIOR TO ANY EXCAVATION

☐ IMPROVEMENT PERMIT *with plat* valid without expiration. ☐ IMPROVEMENT PERMIT *with site plan* valid for 60 mos. ☐ AUTHORIZATION TO CONSTRUCT valid for period equal to IMPROVEMENT PERMIT--not to exceed 60 mo.

Owner / Applicant Signature: Phyllis B Lowrance Date: 10-24-13 Installed by:

IMPROVEMENT PERMIT by: Date: OPERATION PERMIT by: Date:

AUTHORIZATION TO CONSTRUCT by: Date: Existing System Inspected by: Date: 10-24-13

Health Dept. Copy - WHITE Applicant (Final Approval) - YELLOW Applicant (Conditional Approval) - PINK