IREDELL COUNTY HEALTH DEPARTMENT

STATESVILLE 704-878-5305 MOORESVILLE 704-664-5281

IMPROVEMENT PERMIT / AUTHORIZATION TO CONSTRUCT / OPERATION PERMIT / EXISTING SYSTEM INSPECTION

PERMIT# 079275 PIN# 4659 70 2086 DATE 3/2/99

OWNER OR CONTRACTOR Mitchell Belk PHONE: Business _____ Home 662-7766

ADDRESS 120 Belk Rd. Mooresville, NC 28115

LOCATION 115-2 IN TL Belk Rd. first Mobile Home on (R)

SUBDIVISION No BLOCK / SECTION No LOT No LOT AREA ~ 1.4Ac SITE CLASS. PS DESIGN FLOW 360 L.T.A.R. _____

Septic Tank: 1000/EXIST. Gallons; STB _____ Date _____

Pump Tank: _____ Gallons; PT _____ Date _____

Pump Make: _____ Model _____ Serial No. _____

Nitrification Field: No Fields ~~Square Feet~~ Existing System Linear Feet 400

No Lines 4 Trench Width 36 Max Trench Bottom Depth 36 Gravel Depth SAND

☐ New System ☐ Repair System Type: I, II (III) IV, V, VI

System Description: EXISTING SYSTEM CHECK

Repair System Description: _____

Maintenance Agreement Required: ☐ Yes ☒ No

☒ House/Mod. Home ☐ Mobile Home ☐ Business ☐ Other

No. Bedrooms 3 No. Bathrooms 3 No. Employees _____


☐ Slab ☒ Crawl Space ☐ Basement w/plumbing ☐ Basement wo/plumbing

Water Supply: ☒ Individual ☐ Public ☐ Community

Comments:/Conditions:

Comments:/Conditions:
No evidence of problems.

~~INITIAL SITE SKETCH~~ AS BUILT SKETCH

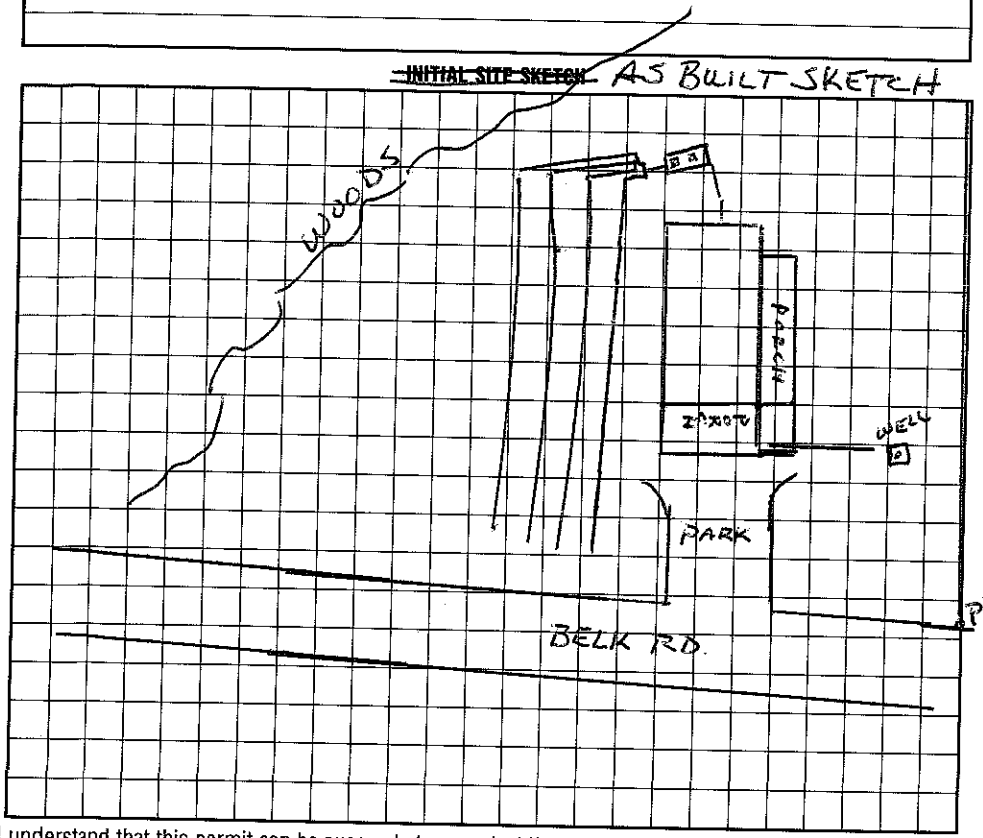

~~AS BUILT SKETCH~~

I understand that this permit can be suspended or revoked if any false information is supplied toward securing the permit/any unauthorized changes are made to the site/any unauthorized changes are made in the installation of the system. Improvement Permit with plat valid without expiration. Improvement Permit with site plan valid for sixty months. Authorization to Construct is valid for a period equal to that of Improvement Permit – not to exceed sixty months.

Signed: ~~X~~ Mitchell R. Belk date 3-3-99

Improvement Permit by: _____ date _____

Authorization to Construct by: _____ date _____

Installed by: Orbison Const. Co. - 1995

Operation Permit by: _____ date _____

Existing System Inspection by: Wesley Sparkman date 3/2/99

HEALTH DEPT. COPY: WHITE INSPECTION COPY (FINAL): GREEN OWNER COPY (FINAL): YELLOW INSPECTION COPY (INITIAL): PINK OWNER COPY (INITIAL): GOLD