IREDELL COUNTY HEALTH DEPARTMENT

Statesville Phone TR 3-7271 Mooresville Phone NO 3-1271

PERMIT TO INSTALL SEPTIC TANK

Permit No. _____ Permit Date 1-8 1964

Owner VANDEN BURK ME. CHURCH Address SHEPHARDS (MOORESVILLE R.F.D.)

Installed By _____ Address _____


Location of Property FROM STATESVILLE PASS SHEPHARDS SCHOOL 1ST DIRT CHURCH ON LEFT

Tank		Capacity		Length of Lines		Fixtures	
Block	( )	1000	(✓)	225'	(✓)	No. of Baths	( )
Precast	(✓)	1250	( )	250'	( )	Dishwasher	( )
		1500	( )	Other _____		Garbage Grdr.	( )
		Other _____				Other _____	

NOTIFY HEALTH DEPARTMENT AT LEAST EIGHT HOURS BEFORE TANK IS TO BE INSPECTED.

Final Inspection 1-8 1964 Approved (✓) Disapproved ( )

Remarks _____

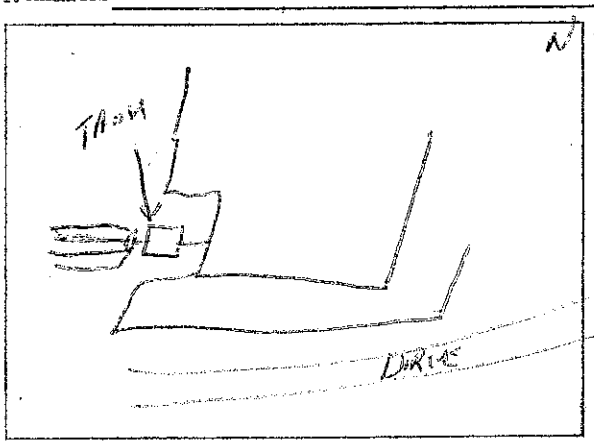

Sketch of Installation

Richard C. Thomas R.S.

Sanitarian