IREDELL COUNTY HEALTH DEPARTMENT

Statesville Phone TR 3-7271 . Mooresville Phone No. 664-5281

PERMIT TO INSTALL SEPTIC TANK

Permit No. 180 Permit Date 7-19-1973

Owner Vandemburg Methodist Parsonage Address Mooresville

Installed By David Kount Address Statesville


Location of Property US 21 & NC 115 North

| Tank | | Capacity | | Length of Lines | | Fixtures | |
|---|---|---|---|---|---|---|---|
| Block | ( ) | 1000 | ( ) | 225' | ( ) | No. of Baths | ( ) |
| Precast | ( ) | 1250 | ( ) | 250' | ( ) | Dishwasher | ( ) |
| | | 1500 | ( ) | Other 150' | | Garbage Grdr. | ( ) |
| | | Other | | | | Other | |

NOTIFY HEALTH DEPARTMENT AT LEAST EIGHT HOURS BEFORE TANK IS TO BE INSPECTED.

Final Inspection 7-19. 1973 Approved (✓) Disapproved ( )

Remarks Repair Job

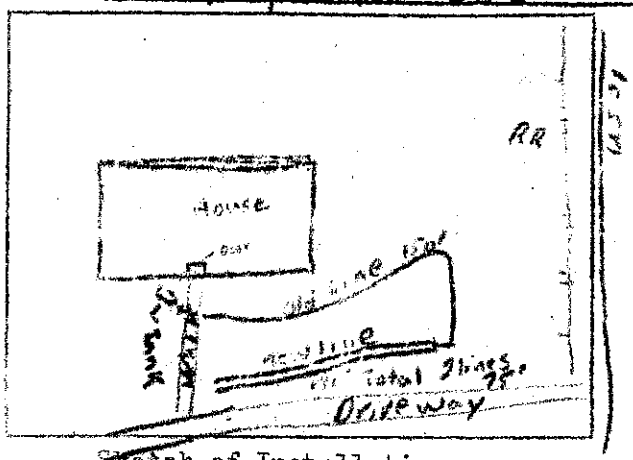


Sketch of Installation

J. C. Moore

Sanitarian