2:00

IREDELL COUNTY HEALTH DEPARTMENT

TATESVILLE 704-878-5305 MOORESVILLE 704-664-5281

IMPROVEMENT PERMIT / AUTHORIZATION TO CONSTRUCT / OPERATION PERMIT / EXISTING SYSTEM INSPECTION

PERMIT# Repair PIN# 4659721519 DATE 5/4/04

OWNER OR CONTRACTOR Bobbie Brown PHONE: Business _____ Home _____

ADDRESS 173 Shepards Rd Mooresville NC 28115

LOCATION 115 N, Ft Shepards, on Lt just Past Roseland #173

SUBDIVISION _____ BLOCK / SECTION _____ LOT _____ LOT AREA 2.85 AC SITE CLASS. PS DESIGN FLOW 360 L.T.A.R. _____

Septic Tank: Existing * Gallons; STB _____ Date _____

Pump Tank: _____ Gallons; PT _____ Date _____

Pump Make: _____ Model _____ Serial No. 230'

Nitrification Field: No Fields 1 Square Feet 990 Linear Feet ~~330~~

No Lines 5 Trench Width 36" Max Trench Bottom Depth 36" Gravel Depth 12"

☐ New System ☒ Repair System Type: I, II, III, IV, V, VI

System Description: ~~25% Red.~~

Repair System Description: Gravity

Maintenance Agreement Required: ☐ Yes ☒ No

☒ House/Mod. Home No. Bedrooms 3

☐ Mobile Home No. Bathrooms 3

☐ Business No. Employees _____

☐ Other _____


☐ Slab ☒ Crawl Space ☐ Basement w/plumbing ☐ Basement wo/plumbing

Water Supply: ☒ Individual ☐ Public ☐ Community


Comments:/Conditions: * May need to replace Tank 1000gal.

Comments:/Conditions:

INITIAL SITE SKETCH

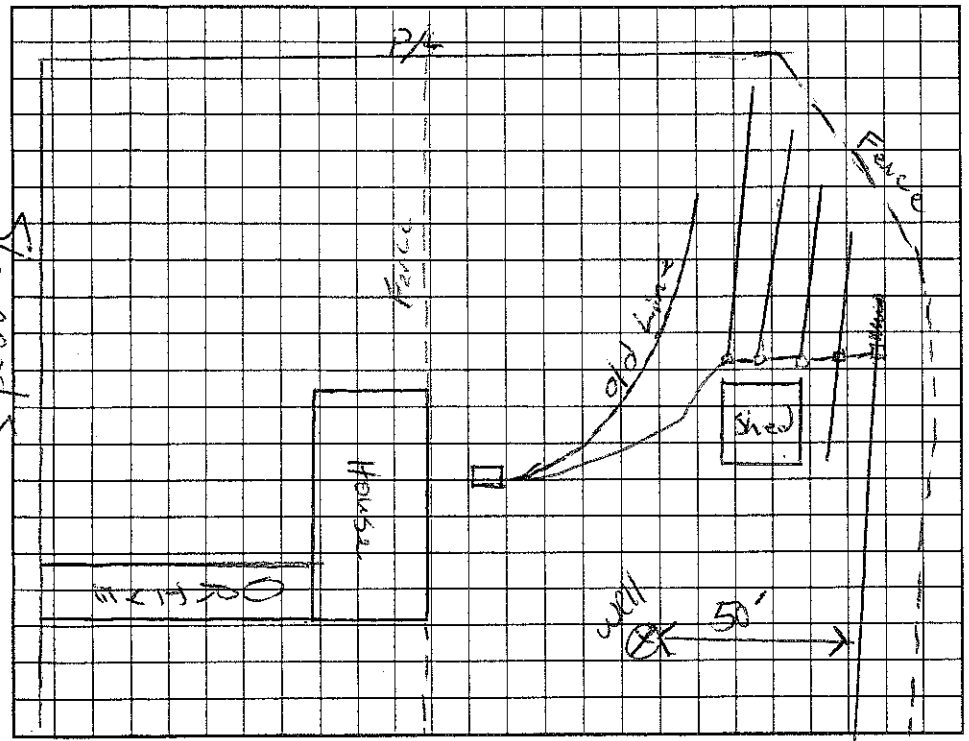

AS BUILT SKETCH

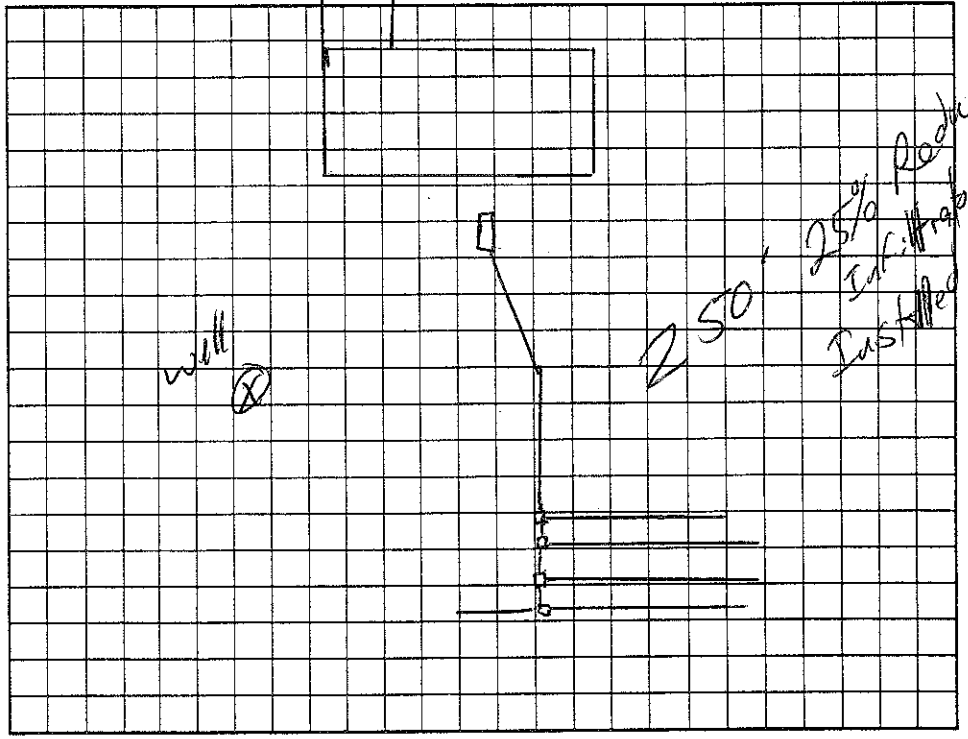

Permit can be suspended or revoked if any false information is supplied toward securing the permit/any unauthorized changes are made to the site/any unauthorized changes are made in the installation of the system. Improvement Permit with plat valid without expiration. Improvement Permit with site plan valid for sixty months. Authorization to Construct is valid for a period equal to that of Improvement Permit – not to exceed sixty months.

Signed: Bobbie J Brown date 5/4/04

Improvement Permit by: RS date 5/4/04

Authorization to Construct by: RS date 5/4/04

Installed by: Rowan Septic

Operation Permit by: RS date 7/2/04

Existing System Inspection by: _____ date _____

HEALTH DEPT. COPY: WHITE OWNER COPY (FINAL): YELLOW OWNER COPY (INITIAL): PINK