IREDELL COUNTY HEALTH DEPARTMENT

STATESVILLE 704-878-5305 | MOORESVILLE 704-664-5281

IMPROVEMENT PERMIT / CERTIFICATE OF COMPLETION / OPERATION PERMIT / EXISTING SYSTEM INSPECTION

4659725447

PROPERTY DESCRIPTION NO. Repair DATE 6/10/96 TAX MAP NO. Repair

OWNER OR CONTRACTOR Kathy Bradshaw PHONE: Business 663-7673 Home 664-5750

ADDRESS 165 Shepherd RD. Watershed: ☐ Yes ☒ No

LOCATION 21 N - TR Shepherd Rd - Corner of Roseland Dr & Shepherd Rd

SUBDIVISION — BLOCK / SECTION — LOT — LOT AREA — SITE CLASS. PS DESIGN FLOW 360gpd L.T.A.R. .3 gpd/sq ft

Septic Tank: existing Gallons; STB — Date —

Pump Tank: — Gallons; PT — Date —

Pump Make: — Model — Serial No. —

Nitrification Field: No Fields 1 Square Feet 900 Linear Feet 300

No Lines 4 Trench Width 36" Max Trench Bottom Depth 36" Gravel Depth N/A

☐ New System ☑ Repair System Type: I, II, (III), IV, V, VI

System Description: gravity chambered

Repair System Description: —

Maintenance Agreement Required: ☐ Yes ☑ No

☑ House/Mod. Home No. Bedrooms 3

☐ Mobile Home No. Bathrooms 2

☐ Business No. Employees —

☐ Other —


☐ Slab ☑ Crawl Space ☐ Basement w/plumbing ☐ Basement wo/plumbing

Water Supply: ☑ Individual ☐ Community ☑ Public


Comments: Cut off old system. 300' of Chambers in front yard. Last line may be slightly deeper than the rest of lines. Water lines needs to be 10' from system.

Comments:

INITIAL SITE SKETCH

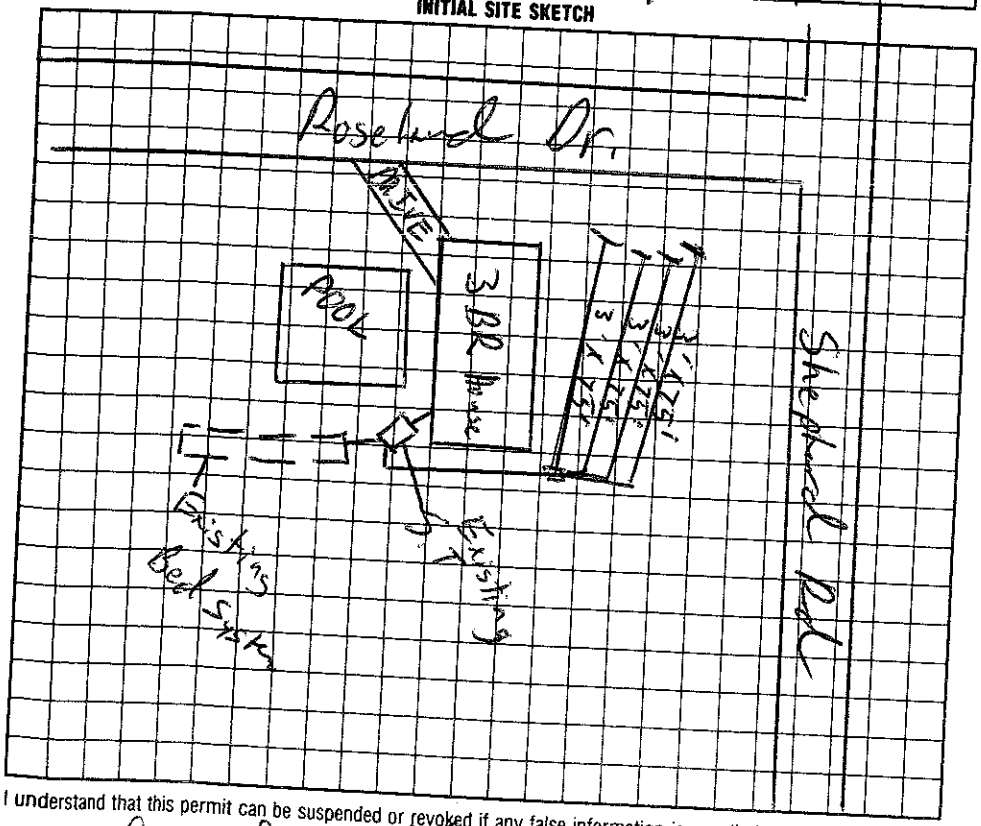

AS BUILT SKETCH

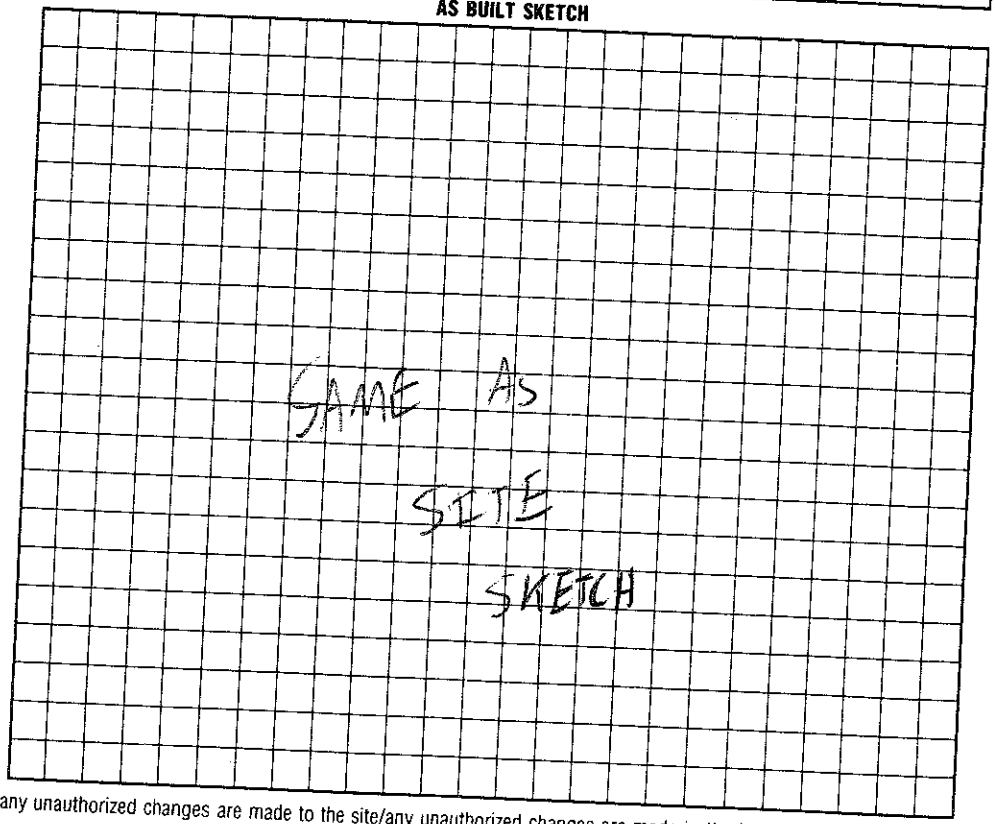

I understand that this permit can be suspended or revoked if any false information is supplied toward securing the permit/any unauthorized changes are made to the site/any unauthorized changes are made in the installation of the system.

Signed: Johnny L. Bradshaw

Improvement Permit by: C. Ruby Green date 6/10/96

Existing System Inspection by: C. Ruby Green date 6/10/96

Installed by: LARRY BEAM

Certificate of Completion by: — date —

Operation Permit by: C. Ruby Green date 4/14/97

HEALTH DEPT. COPY: WHITE | INSPECTION COPY (FINAL): GREEN | OWNER COPY (FINAL): YELLOW | INSPECTION COPY (INITIAL): PINK | OWNER COPY (INITIAL): GOLD