IREDELL COUNTY HEALTH DEPARTMENT

STATESVILLE 704-878-5305 MOORESVILLE 704-664-5281

IMPROVEMENT PERMIT / CERTIFICATE OF COMPLETION / OPERATION PERMIT / EXISTING SYSTEM INSPECTION

PROPERTY DESCRIPTION NO. Repair DATE 3/29/96

OWNER OR CONTRACTOR Larry Whisenant TAX MAP NO. PIN 4659 72 6589

ADDRESS 109 W. Rose Loop PHONE: Business Home 662-9753 Watershed: ☐ Yes ☐ No

LOCATION 115 N Shepherd Pl - TR Roseland Ct - W. Idrose Loop

SUBDIVISION Roseland Heights BLOCK / SECTION LOT 20 LOT AREA SITE CLASS. PS DESIGN FLOW 360 L.T.A.R. .35 gal/sq ft

Septic Tank: 1000 Gallons; STB Date

Pump Tank: Gallons; PT Date

Pump Make: Model Serial No.

Nitrification Field: No Fields Square Feet 520 Linear Feet 240

No Lines 4 Trench Width 36" Max Trench Bottom Depth 36" Gravel Depth 19

☐ New System ☑ Repair System Type: I, II, III, IV, V, VI

System Description: gravity Chambered

Repair System Description:

Maintenance Agreement Required: ☐ Yes ☑ No

☑ House/Mod. Home No. Bedrooms 3

☐ Mobile Home No. Bathrooms 2

☐ Business No. Employees

☐ Other


☐ Slab ☑ Crawl Space ☐ Basement w/plumbing ☐ Basement wo/plumbing

Water Supply: ☑ Individual ☐ Community ☑ Public

Comments: Water line needs to be 10' from septic lines.

Comments:

INITIAL SITE SKETCH

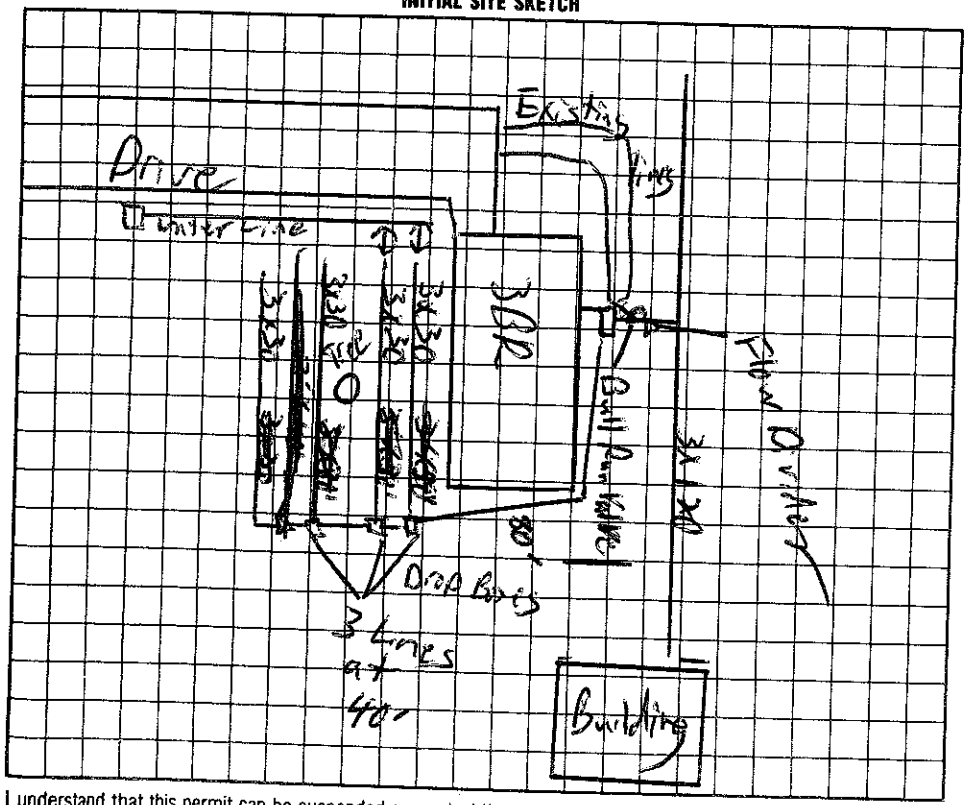

AS BUILT SKETCH

I understand that this permit can be suspended or revoked if any false information is supplied toward securing the permit/any unauthorized changes are made to the site/any unauthorized changes are made in the installation of the system.

Signed:

Improvement Permit by: C. Brady Stevens date 4/2/96

Existing System Inspection by: C. Brady Stevens date 4/2/96

Installed by: EJ Ervin

Certificate of Completion by: date

Operation Permit by: C. Brady Stevens EHSI date 5/9/96

HEALTH DEPT. COPY: WHITE INSPECTION COPY (FINAL): GREEN OWNER COPY (FINAL): YELLOW INSPECTION COPY (INITIAL): PINK OWNER COPY (INITIAL): GOLD