IREDELL COUNTY HEALTH DEPARTMENT

STATESVILLE 704-878-5305 MOORESVILLE 704-664-5281

IMPROVEMENT PERMIT / AUTHORIZATION TO CONSTRUCT / OPERATION PERMIT / EXISTING SYSTEM INSPECTION

PERMIT# 114 6021 PIN# 4659 73 0725 DATE 8/5/03

OWNER OR CONTRACTOR James Schronce PHONE: Business Home 664-3329

ADDRESS 223 Shepherd Rd Mooresville, NC 28115 (249 Shepherd Rd)

LOCATION Hwy 115/21 North TR Shepherd Rd on left 1/2 mile

SUBDIVISION BLOCK / SECTION LOT LOT AREA 22.10 Acres SITE CLASS. PS DESIGN FLOW 240 L.T.A.R. .3

Septic Tank: 1000 Gallons; STB 760 Date 1/16/03
Pump Tank: Gallons; PT Date
Pump Make: Model Serial No.
Nitrification Field: No Fields 1 Square Feet 810' Linear Feet 270'
No Lines 3@90' Trench Width 36" Max Trench Bottom Depth 24" Gravel Depth 12"

☒ New System ☐ Repair System Type: I, II, III, IV, V, VI
System Description: Gravity Conventional
Repair System Description: Same
Maintenance Agreement Required: ☐ Yes ☒ No


☐ House/Mod. Home No. Bedrooms 2
☒ Mobile Home No. Bathrooms 1
☐ Business No. Employees
☐ Other
☐ Slab ☒ Crawl Space ☐ Basement w/plumbing ☐ Basement wo/plumbing

Water Supply: ☒ Individual ☐ Shared ☐ Public ☐ Community

Comments:/Conditions: Keep Septic System at least 10' From PL, 100' from existing well & 10' From MH.

Comments:/Conditions:

INITIAL SITE SKETCH ☆ Not to Scale

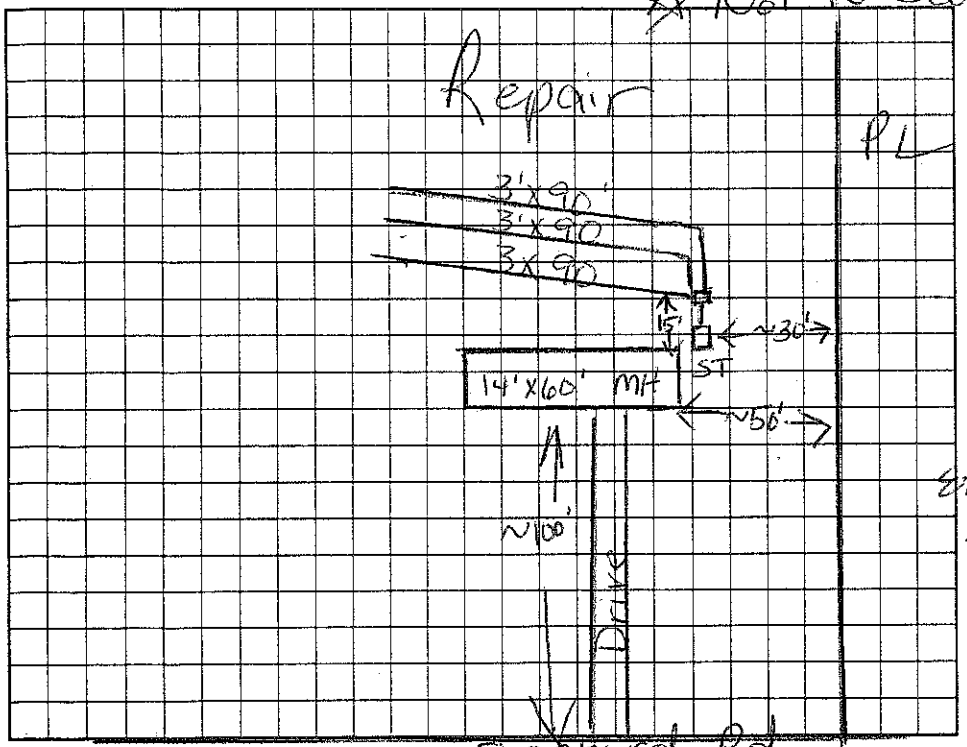

AS BUILT SKETCH

Permit can be suspended or revoked if any false information is supplied toward securing the permit/any unauthorized changes are made to the site/any unauthorized changes are made in the installation of the system. Improvement Permit with plat valid without expiration. Improvement Permit with site plan valid for sixty months. Authorization to Construct is valid for a period equal to that of Improvement Permit – not to exceed sixty months.

Signed: Jacqueline V. Schronce RS date

Improvement Permit by: Maria H. Dotson RS date 8/5/03

Authorization to Construct by: Maria H. Dotson RS date 8/5/03

Installed by: Lump Powell

Operation Permit by: Wesley Sparks RS. date 9/3/03

Existing System Inspection by: date

HEALTH DEPT. COPY: WHITE OWNER COPY (FINAL): YELLOW OWNER COPY (INITIAL): PINK