# IREDELL COUNTY HEALTH DEPARTMENT

STATESVILLE 704-878-5305 MOORESVILLE 704-664-5281

## IMPROVEMENT PERMIT / AUTHORIZATION TO CONSTRUCT / OPERATION PERMIT / EXISTING SYSTEM INSPECTION

PERMIT# Repair PIN# 4605973614 4 DATE 6/20/05

OWNER OR CONTRACTOR Bill Maddecy PHONE: Business 704 582-3386 Home

ADDRESS 200 Shepherd Rd Mooresville NC 28115

LOCATION 115 N to R Shepherd Rd, on Rt on corner of Shepherd Valley

SUBDIVISION Shepherd Valley BLOCK / SECTION LOT 2 LOT AREA ± .5AC SITE CLASS. DS DESIGN FLOW — L.T.A.R. —

Septic Tank: Exist. ~~50~~ gallons; STB Date

Pump Tank: Washer Box gallons; PT Date

Pump Make: Model Serial No.

Nitrification Field: No Fields Square Feet 120 Linear Feet

No Lines Trench Width Max Trench Bottom Depth Gravel Depth

☐ New System ☒ Repair System Type: I, (II), III, IV, V, VI

System Description:

Repair System Description: 6'x 20' 25% Reduct. Bed

Maintenance Agreement Required: ☐ Yes ☒ No

☐ House/Mod. Home No. Bedrooms

☐ Mobile Home No. Bathrooms

☐ Business No. Employees

☐ Other Washer Box


☐ Slab ☒ Crawl Space ☐ Basement w/plumbing ☐ Basement wo/plumbing

Water Supply: ☒ Individual ☐ Public ☐ Community


Comments:/Conditions: New D-Box - Install to Feed New bed First

Comments:/Conditions:

INITIAL SITE SKETCH

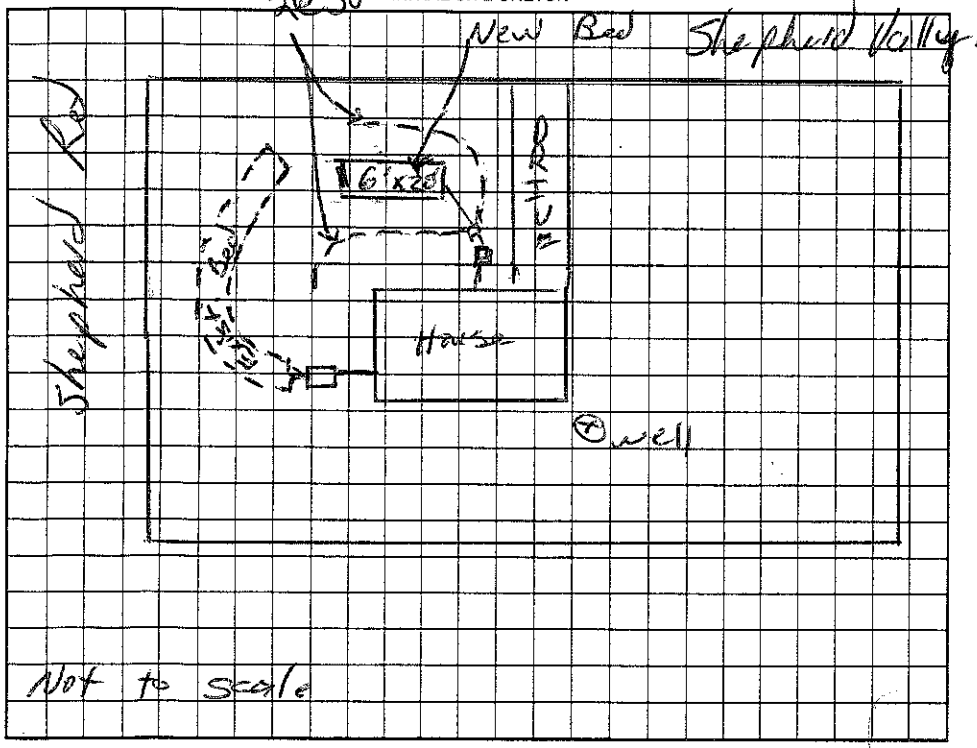


AS BUILT SKETCH

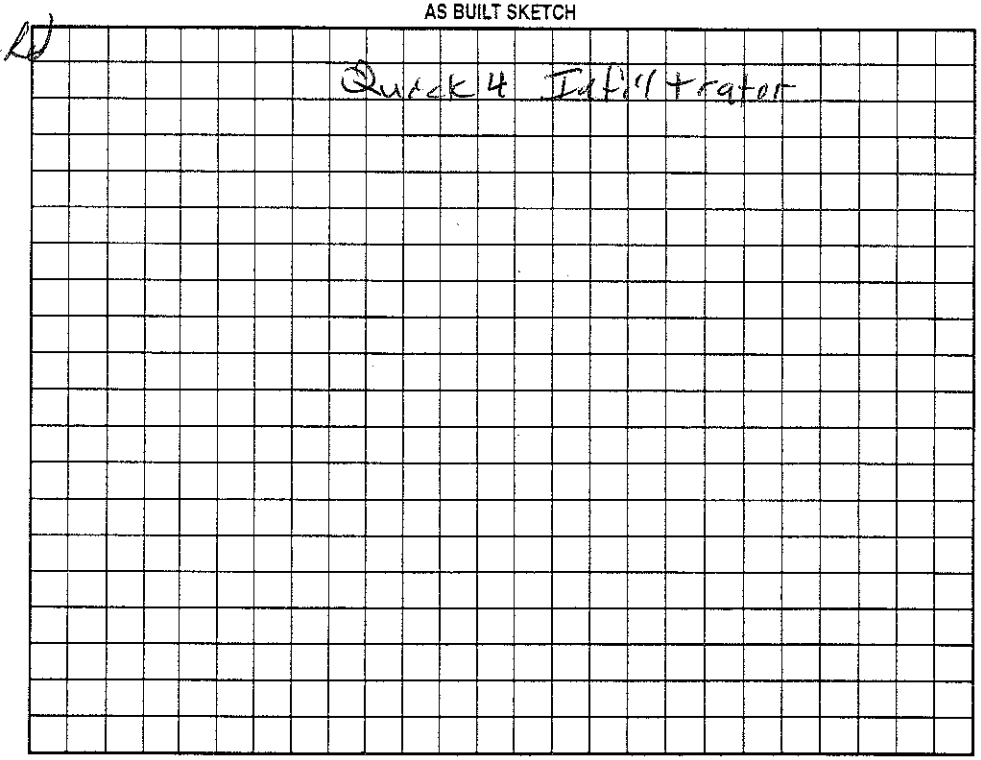


Permit can be suspended or revoked if any false information is supplied toward securing the permit/any unauthorized changes are made to the site/any unauthorized changes are made in the installation of the system. Improvement Permit with plat valid without expiration. Improvement Permit with site plan valid for sixty months. Authorization to Construct is valid for a period equal to that of Improvement Permit – not to exceed sixty months.

Signed: date 6/20/05 Installed by: Piedmont Backhoe

Improvement Permit by: RS date 6/20/05 Operation Permit by: RS date 9/2/05

Authorization to Construct by: RS date 6/20/05 Existing System Inspection by: date

HEALTH DEPT. COPY: WHITE OWNER COPY (FINAL): YELLOW OWNER COPY (INITIAL): PINK