IREDELL COUNTY HEALTH DEPARTMENT - *ENVIRONMENTAL HEALTH* ☐ STATESVILLE OFFICE 704-878-5305 ☑ MOORESVILLE OFFICE 704-664-5281

IMPROVEMENT PERMIT / AUTHORIZATION TO CONSTRUCT / OPERATION PERMIT / EXISTING SYSTEM INSPECTION

PERMIT # 171781 PIN # 4659736950 ✓ DATE 5-8-2012 Deena

OWNER ~~Clayton Hom~~ Rabtoy APPLICANT: Clayton Homes #72 PHONE: Home/Cell # Daniel 704660-1407 Business # 704 239-3693

SITE ADDRESS 2336 Shepherd Rd OWNER / APPLICANT ADDRESS 2026 Northside Dr Statesville, NC. 28677

SITE DIRECTIONS Hwy 115/US21 TR Shepherd ~ 1/2 mile on right

SUBDIVISION Teresa T. Newton BLOCK / SECTION LOT # -1- LOT AREA .471 Ac DESIGN FLOW 360 L.T.A.R.

Existing

Septic Tank 1000 Gallons: STB Date

Pump Tank Gallons: P T Date

Pump Make Model Serial #

No. Nitrification Fields: 1 No. Lines 4 Linear Feet 300'

Trench Width 36" Max. Trench Bottom Depth 36" Gravel Depth 12"

☐ New System ☐ Repair ☐ Expansion System Type I II III IV V VI

System Description: Existing Gravity Conventional

Repair System Description: Modified Conventional

Maintenance Agreement Required ☐ YES ☒ NO

☒ GRAVITY ☐ PRESSURE

☒ Residence No. Bedrooms 3

☐ Business No. Persons

☐ Other No. Employees

☐ Slab ☒ Crawl Space


☐ Basement w/plumbing ☐ Basement w/o plumbing

Water Supply ☒ Private Not Drilled Yet ☐ Public ☐ Community

Comments / Conditions Existing Septic System appears to be functioning OKAY at time of inspection. (Owner says Septic System has not been used in several years)

☒ Must keep new home at least 5FT from ST & Drainfield

INITIAL SITE SKETCH

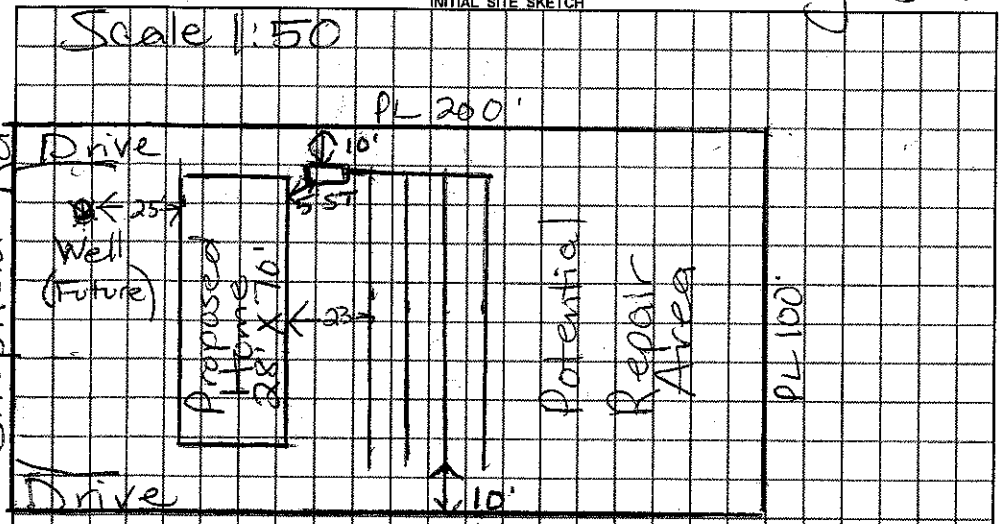

AS BUILT SKETCH

Permit can be suspended or revoked if any false information is supplied toward securing the permit / any unauthorized changes are made to the site / any unauthorized changes are made in the installation of the system.

☐ ***IMPROVEMENT PERMIT*** with plat valid without expiration. ☐ ***IMPROVEMENT PERMIT*** with ~~plat valid without expiration~~ site plan valid 60 mo. ☐ ***AUTHORIZATION TO CONSTRUCT*** valid for period equal to IMPROVEMENT PERMIT--not to exceed 60 mo.

Owner / Applicant Signature: Deena Knee Date 5/9/12 Installed by: FJ Ervin 9/19/91

IMPROVEMENT PERMIT by: ***REHS*** Date

AUTHORIZATION TO CONSTRUCT by: ***REHS*** Date

OPERATION PERMIT by: ***REHS*** Date

Existing System Inspected by: ***REHS*** Date 5/8/12

YOU SHOULD CONTACT A LOCATOR SERVICE PRIOR TO ANY EXCAVATION

White Copy – Environmental Health YELLOW COPY (Final) Owner / Applicant PINK COPY (Initial) Owner / Applicant