IREDELL COUNTY HEALTH DEPARTMENT

STATESVILLE 704-878-5305 MOORESVILLE 704-664-5281

IMPROVEMENT PERMIT / AUTHORIZATION TO CONSTRUCT / OPERATION PERMIT / EXISTING SYSTEM INSPECTION

400

PERMIT# 084019 PIN# 4659 74 0251 4659 74 0251 DATE 10/13/99

OWNER OR CONTRACTOR Teresa Newton PHONE: Business 528-0810 Home

ADDRESS 255 Shepherds Rd. Mooresville, NC. 28115

LOCATION Shepherds Rd, 115 N TR Shepherds Rd. ~ .7 mile on (L)

SUBDIVISION No BLOCK / SECTION LOT No LOT AREA .81 AC SITE CLASS. P5 DESIGN FLOW 360 L.T.A.R. .3

Septic Tank: 1000 Gallons; STB 1012 Date 8/20/99
Pump Tank: Gallons; PT Date
Pump Make: Model Serial No.
Nitrification Field: No Fields 1 Square Feet 1960 Linear Feet 980
No Lines 7 Trench Width 36" Max Trench Bottom Depth 36" Gravel Depth SAND

☒ New System ☐ Repair System Type: I, II, (III), IV, V, VI
System Description: GRAVITY - ~~ON DEMAND~~ C
Repair System Description: SAME
Maintenance Agreement Required: ☐ Yes ☒ No


☐ House/Mod. Home ☒ Mobile Home ☐ Business ☐ Other
No. Bedrooms 3 No. Bathrooms 2 No. Employees
☐ Slab ☐ Crawl Space ☐ Basement w/plumbing ☐ Basement wo/plumbing

Water Supply: ☒ Individual ☐ Public ☐ Community


Comments/Conditions:

Comments/Conditions:
MAY USE CONVENTIONAL DRAINFIELD.

INITIAL SITE SKETCH

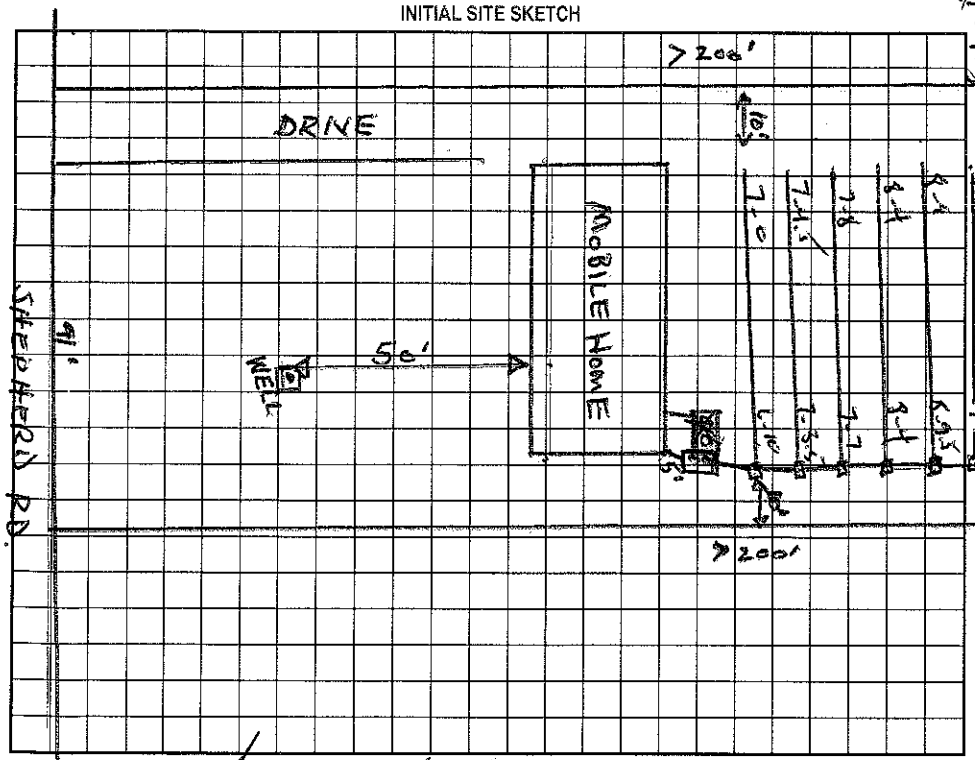

AS BUILT SKETCH

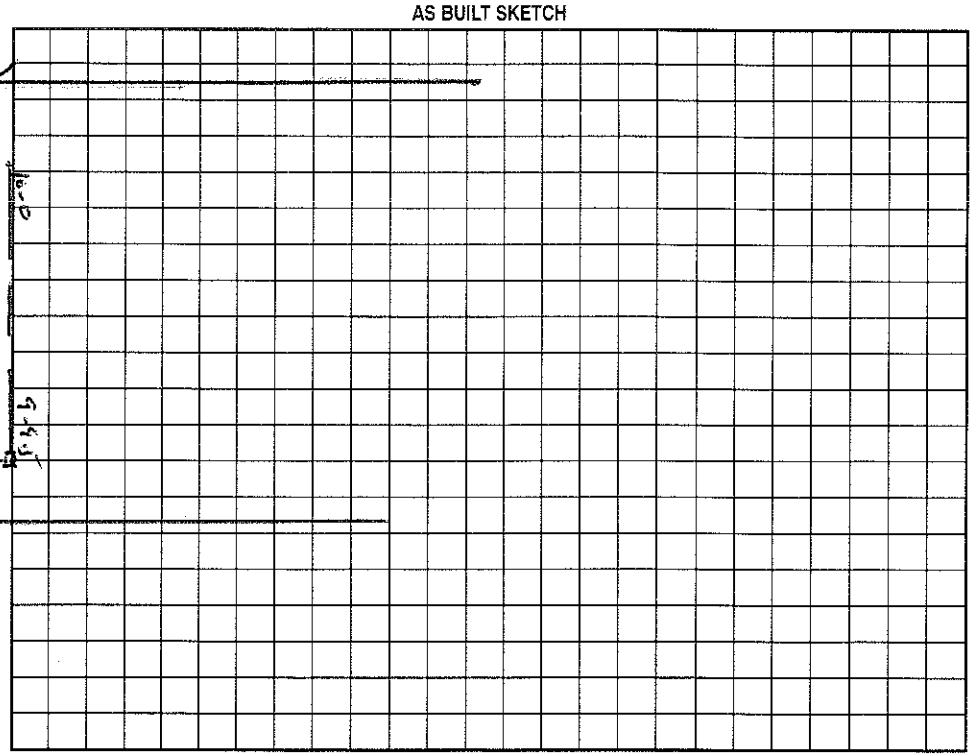

Permit can be suspended or revoked if any false information is supplied toward securing the permit/any unauthorized changes are made to the site/any unauthorized changes are made in the installation of the system. Improvement Permit with plat valid without expiration. Improvement Permit with site plan valid for sixty months. Authorization to Construct is valid for a period equal to that of Improvement Permit – not to exceed sixty months.

Signed: Teresa Newton date

Installed by: A-1 Backhoe

Improvement Permit by: Wesley Sparks R.S. date 10/13/99

Operation Permit by: Wesley Sparks R.S. date 11/10/99

Authorization to Construct by: Wesley Sparks R.S. date 10/13/99

Existing System Inspection by: date

HEALTH DEPT. COPY: WHITE OWNER COPY (FINAL): YELLOW OWNER COPY (INITIAL): PINK