IREDELL COUNTY HEALTH DEPARTMENT

Authorization to Construct — 4659 74 6972

STATESVILLE 704-878-5305 — MOORESVILLE 704-664-5281

IMPROVEMENT PERMIT / CERTIFICATE OF COMPLETION / OPERATION PERMIT / EXISTING SYSTEM INSPECTION

PROPERTY DESCRIPTION NO. 23512 DATE 4/26/96 TAX MAP NO. 40A38 Watershed: ☐ Yes ☒ No

OWNER OR CONTRACTOR Harold Livengood PHONE: Business _____ Home 663-7438

ADDRESS 490 Shepard Rd. Mooresville, NC.

LOCATION Shepard Rd. ; 8 miles on (R)

SUBDIVISION N/A BLOCK / SECTION _____ LOT _____ LOT AREA 1.0 Ac SITE CLASS. PS DESIGN FLOW 360 L.T.A.R. .3

Septic Tank: 1000 Gallons; STB 794 Date 9-21-95

Pump Tank: _____ Gallons; PT _____ Date _____

Pump Make: _____ Model _____ Serial No. _____

Nitrification Field: No Fields 1 Square Feet 1200 Linear Feet 400

No Lines 4 Trench Width 36" Max Trench Bottom Depth 36" Gravel Depth 12"

☒ New System ☐ Repair System Type: I. II. III. IV. V. VI

System Description: Conv.

Repair System Description: Conv.

Maintenance Agreement Required: ☐ Yes ☐ No

☐ House/Mod. Home No. Bedrooms 3

☒ Mobile Home No. Bathrooms 1

☐ Business No. Employees _____

☐ Other _____


☐ Slab ☒ Crawl Space ☐ Basement w/plumbing ☐ Basement wo/plumbing

Water Supply: ☒ Individual ☐ Community ☐ Public DA05


Comments:

Comments:

INITIAL SITE SKETCH

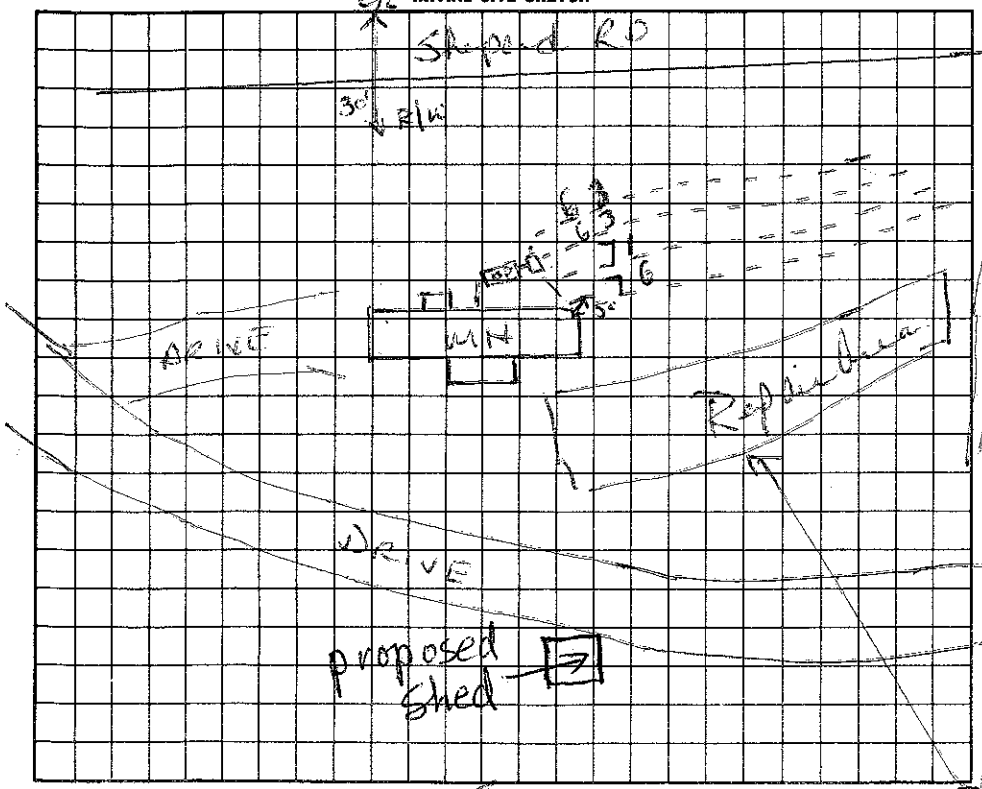

AS BUILT SKETCH

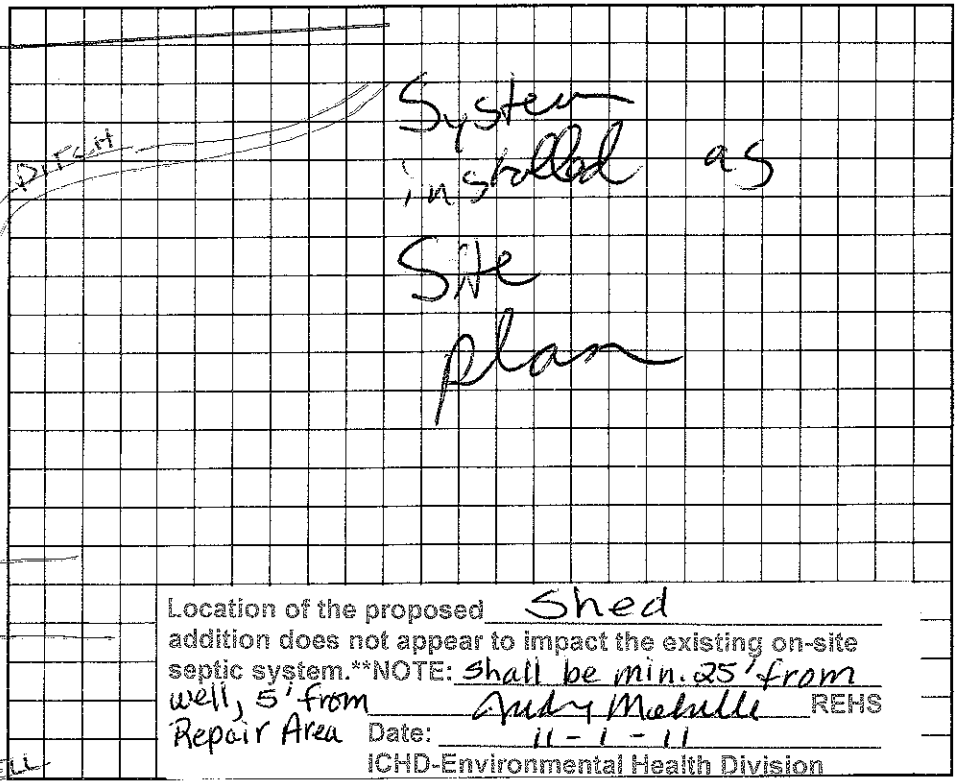

Location of the proposed Shed addition does not appear to impact the existing on-site septic system.**NOTE: Shall be min. 25' from well, 5' from Repair Area

Andy Melville REHS

Date: 11-1-11

ICHD-Environmental Health Division

I understand that this permit can be suspended or revoked if any false information is supplied toward securing the permit/any unauthorized changes are made to the site/any unauthorized changes are made in the installation of the system.

Signed: Harold Livengood

Installed by: FJ Ervin

Improvement Permit by: Wesley Sparks R.S. date 4/26/96

Certificate of Completion by: _____ date _____

Existing System Inspection by: Wesley Sparks R.S. date 4/26/96

Operation Permit by: C. Rudy Kaan EHSI date 5/7/96

HEALTH DEPT. COPY: WHITE — INSPECTION COPY (FINAL): GREEN — OWNER COPY (FINAL): YELLOW — INSPECTION COPY (INITIAL): PINK — OWNER COPY (INITIAL): GOLD