IREDELL COUNTY HEALTH DEPARTMENT

Authorization to Construct

STATESVILLE 704-878-5305 MOORESVILLE 704-664-5281

IMPROVEMENT PERMIT / CERTIFICATE OF COMPLETION / OPERATION PERMIT / EXISTING SYSTEM INSPECTION

PROPERTY DESCRIPTION NO. 23512 DATE 4/26/96 TAX MAP NO. 40A38 Watershed: ☐ Yes ☒ No

OWNER OR CONTRACTOR Harold Livengood PHONE: Business _____ Home 663-7438

ADDRESS 290 Shepard Rd. Mooresville NC

LOCATION Shepard Rd. 1.8 mi on (2)

SUBDIVISION N/A BLOCK / SECTION _____ LOT _____ LOT AREA 1.04c SITE CLASS. PS DESIGN FLOW 360 L.T.A.R. .3

Septic Tank: 1000 Gallons; STB 794 Date 9-21-95

Pump Tank: _____ Gallons; PT _____ Date _____

Pump Make: _____ Model _____ Serial No. _____

Nitrification Field: No Fields 1 Square Feet 1200 Linear Feet 400

No Lines 4 Trench Width 36" Max Trench Bottom Depth 36" Gravel Depth 12"

☒ New System ☐ Repair System Type: I, ☒ III, IV, V, VI

System Description: Conv.

Repair System Description: Conv.

Maintenance Agreement Required: ☐ Yes ☐ No

☐ House/Mod. Home No. Bedrooms 3

☒ Mobile Home No. Bathrooms 1

☐ Business No. Employees _____

☐ Other _____


☐ Slab ☒ Crawl Space ☐ Basement w/plumbing ☐ Basement wo/plumbing

Water Supply:
☒ Individual
☐ Community
☐ Public
DADS


Comments:

Comments:

INITIAL SITE SKETCH

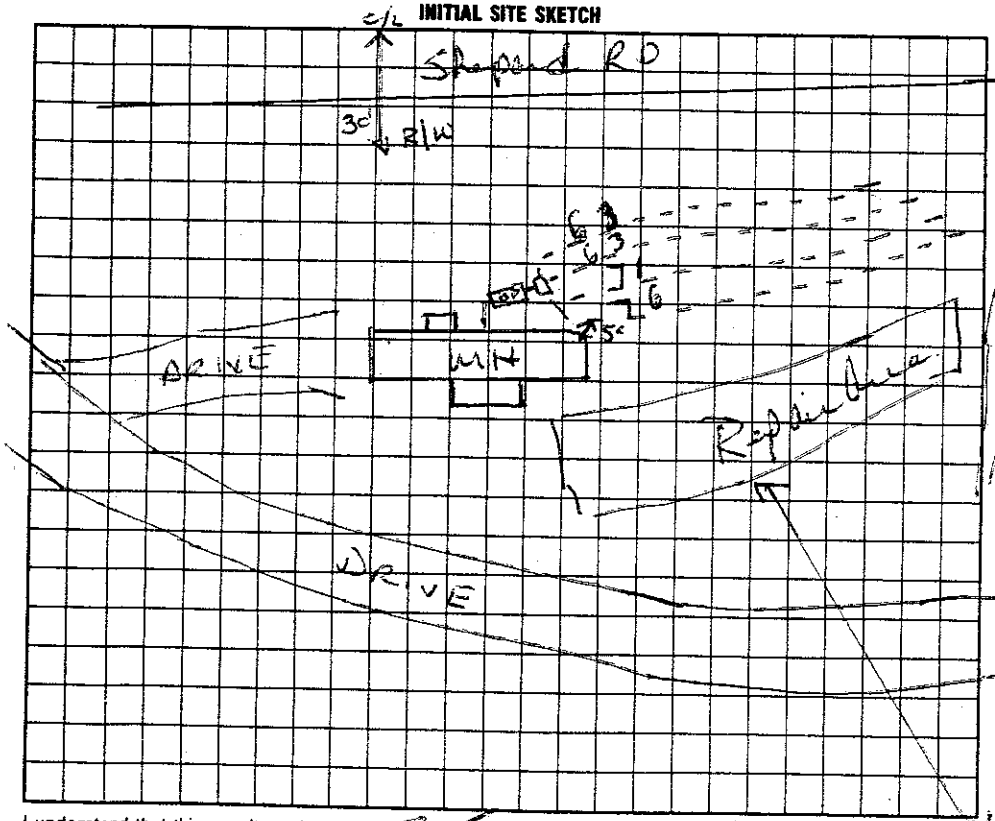

AS BUILT SKETCH

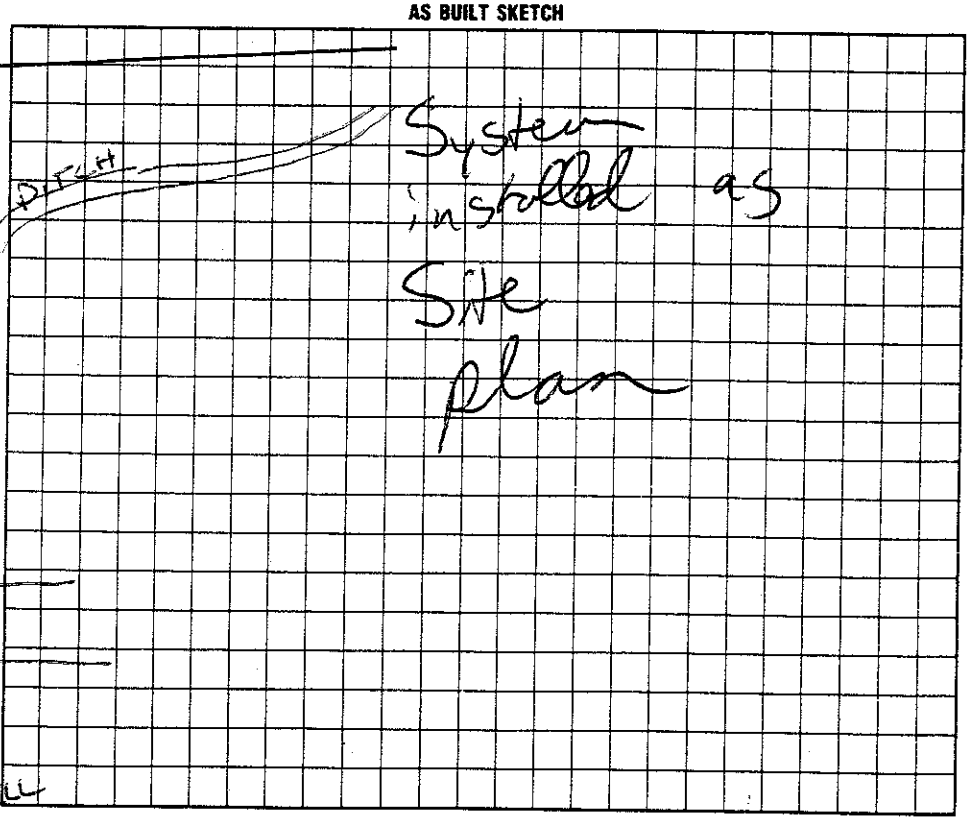

I understand that this permit can be suspended or revoked if any false information is supplied toward securing the permit/any unauthorized changes are made to the site/any unauthorized changes are made in the installation of the system.

Signed: Harold Livengood

Improvement Permit by: Wesley Sparks RS date 4/26/96

Existing System Inspection by: Wesley Sparks RS date 4/26/96

Installed by: FJ Ervin

Certificate of Completion by: _____ date _____

Operation Permit by: C. Brady Koon EHSI date 5/7/96

HEALTH DEPT. COPY: WHITE INSPECTION COPY (FINAL): GREEN OWNER COPY (FINAL): YELLOW INSPECTION COPY (INITIAL): PINK OWNER COPY (INITIAL): GOLD