IREDELL COUNTY HEALTH DEPARTMENT

Authorization to Construct

10:00 - 10:30

STATESVILLE 704-878-5305 MOORESVILLE 704-664-5281

IMPROVEMENT PERMIT / ~~CERTIFICATE OF COMPLETION~~ / OPERATION PERMIT / EXISTING SYSTEM INSPECTION

PROPERTY DESCRIPTION NO. 66254 DATE 5/1/97 TAX MAP NO. 4659747761 PT Watershed: ☐ Yes ☒ No

OWNER OR CONTRACTOR Rick L Moore PHONE: Business 4659747441 Home 663-1621

ADDRESS 131 N Church St. Mooresville NC. 28115

LOCATION Shepherds Rd. on ® ~ .7 mile from 115-21N

SUBDIVISION N/A BLOCK / SECTION ____ LOT N/A LOT AREA ~ 2 AC SITE CLASS. PS DESIGN FLOW 360 L.T.A.R. .25

Septic Tank: 1000 Gallons; STB 794 Date 9/8/97

Pump Tank: ____ Gallons; PT ____ Date ____

Pump Make: ____ Model ____ Serial No. ____

Nitrification Field: No Fields 1 Square Feet 1440 Linear Feet 480

No Lines 4 Trench Width 36" Max Trench Bottom Depth 36" Gravel Depth 12"

☒ New System ☐ Repair System Type: I (II) III, IV, V, VI

System Description: CONV - DBOX - SPD. LVLRS

Repair System Description: SAME

Maintenance Agreement Required: ☐ Yes ☒ No

☒ House/Mod. Home No. Bedrooms 3

☐ Mobile Home No. Bathrooms 2

☐ Business No. Employees ____

☐ Other ____


☐ Slab ☒ Crawl Space ☐ Basement w/plumbing ☐ Basement wo/plumbing

Water Supply: ☒ Individual ☐ Community ☐ Public


Comments: * LOCATE GAS PIPELINE *
LINES ON CONTOUR AS SHOWN
[4 @ 120' X 3']

Comments:

INITIAL SITE SKETCH

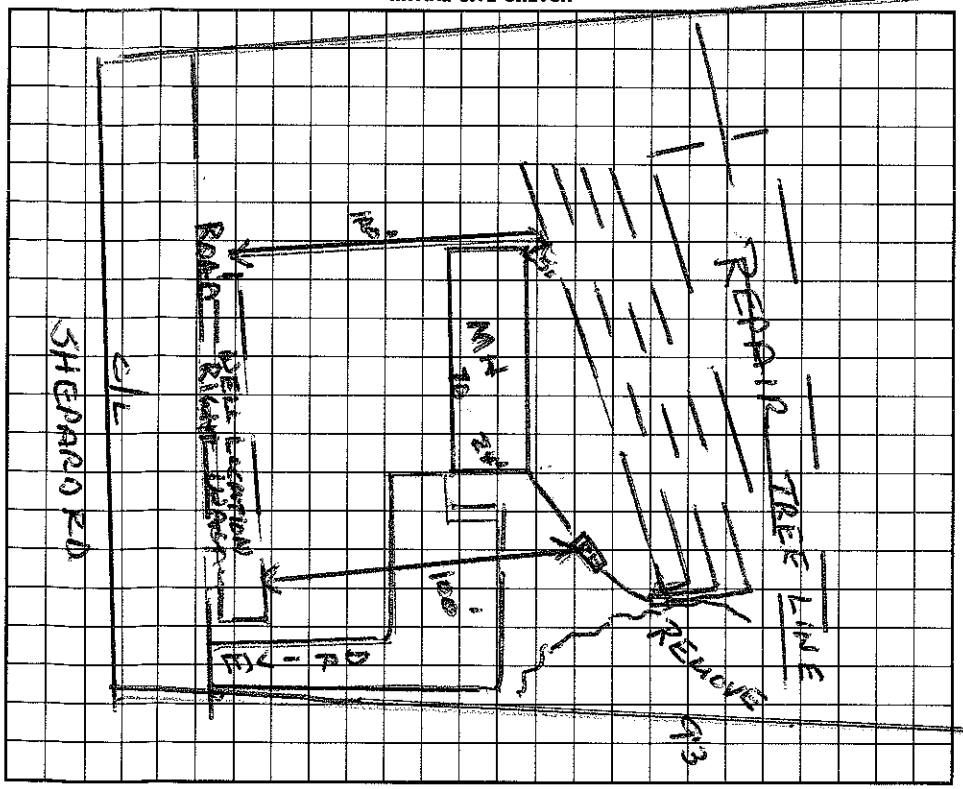

AS BUILT SKETCH

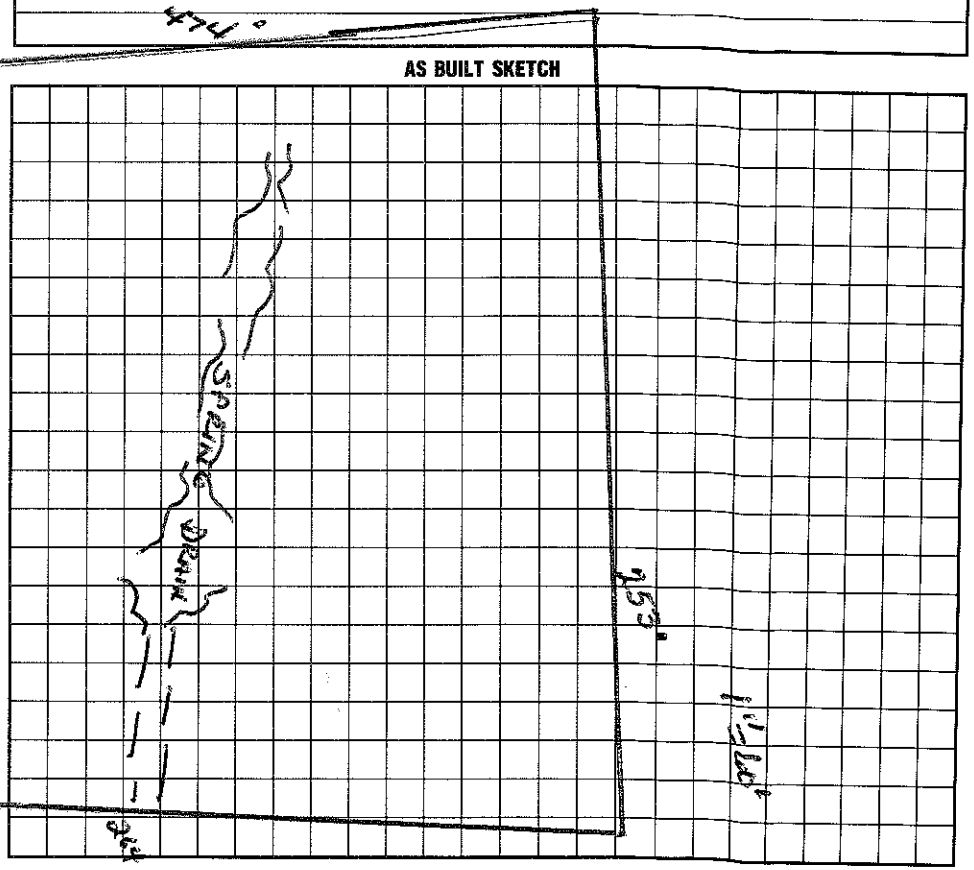

I understand that this permit can be suspended or revoked if any false information is supplied toward securing the permit/any unauthorized changes are made to the site/any unauthorized changes are made in the installation of the system. Improvement Permit is valid for 60 months from date of issuance.

Signed: * Ricky L. Moore

Improvement Permit by: Wesley Spencer RS. date 5/1/97

Authorization to Construct by: Wesley Spencer RS date 5/1/97

Installed by: BJR CONSTRUCTION

Certificate of Completion by: ____ date ____

Operation Permit by: C. Ray Green date 11/21/97

HEALTH DEPT. COPY: WHITE INSPECTION COPY (FINAL): GREEN OWNER COPY (FINAL): YELLOW INSPECTION COPY (INITIAL): PINK OWNER COPY (INITIAL): GOLD