4:00

IREDELL COUNTY HEALTH DEPARTMENT

STATESVILLE 704-878-5305 MOORESVILLE 704-664-5281

IMPROVEMENT PERMIT / AUTHORIZATION TO CONSTRUCT / OPERATION PERMIT / EXISTING SYSTEM INSPECTION

PERMIT # 154854 PIN # 4659747732 DATE 2-25-2009

OWNER or APPLICANT Freedom Homes PHONE: Business 704 528-7960 Home: 704 658-1723 Rollins

OWNER or APPLICANT ADDRESS 1124 Charlotte Hwy Troutman, NC 28166

LOCATION / DIRECTIONS Hwy 115/21 TR Shepherd Rd ~ ½ mile on right Bt Staff Ln

SUBDIVISION Newton Place BLOCK / SECTION LOT # 2 LOT AREA .74Acre DESIGN FLOW 480gpd L.T.A.R. .25Initial

Shoaf

Septic Tank 1000 Gallons: STB 760 Date 10-7-08 ☒ New System ☐ Repair ☐ Expansion System Type I (II) III IV V VI

Pump Tank ____ Gallons: PT ____ Date ____ System Description: Gravity - 25% Reduction

Pump Make ____ Model 7 Serial # ____ Repair System Description: Same

Nitrification Field No Fields 1 No Lines ~~Lateral~~ Linear Feet 480 FT Maintenance Agreement Required ☐ YES ☒ NO

Trench Width 36" Max. Trench Bottom Depth 38"-40" Gravel Depth N/A ☒ GRAVITY ☐ PRESSURE

☒ Residence No. Bedrooms 4 ☐ Business No. Persons ____ ☐ Other No. Employees ____ ☐ Slab ☐ Crawl Space ☐ Basement w/plumbing ☐ Basement w/o plumbing


Water Supply: ☒ Private ☐ Public ☐ Community

Comments / Conditions: Note: Maintain 38" to 40" trench bottom. Keep drainfield at least 50Ft from any well. Keep Septic System out of ROW for OHE


Comments / Conditions: Installed Quick 4 "EndFeed w/ Built in drop boxes"

~~5080'~~ 1-56 1-52 1-80

INITIAL SITE SKETCH

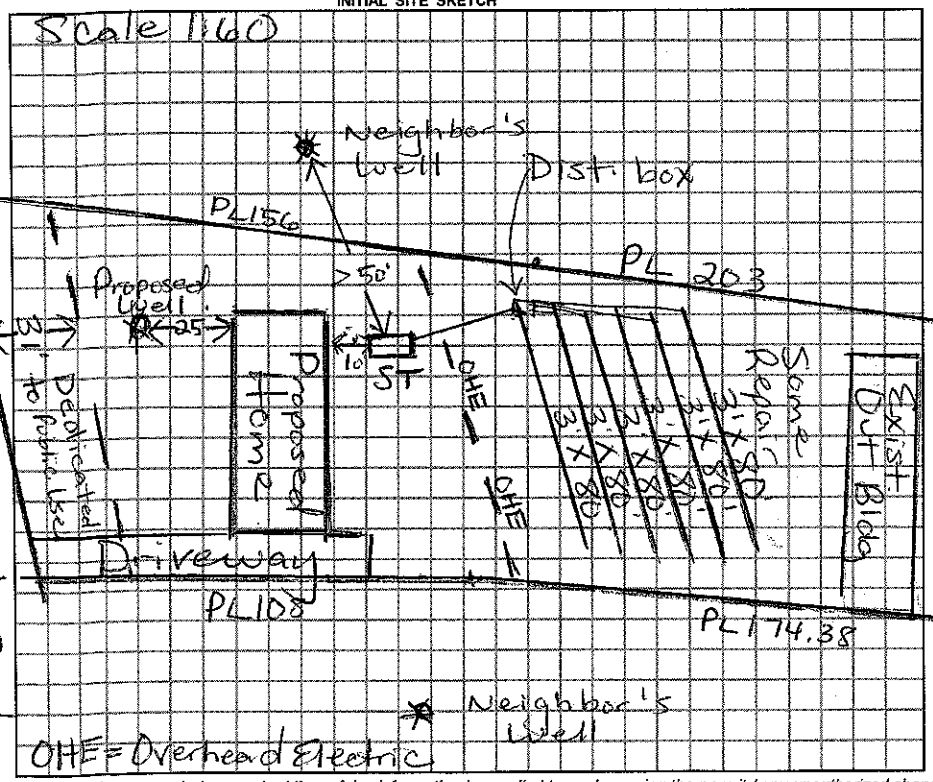

AS BUILT SKETCH

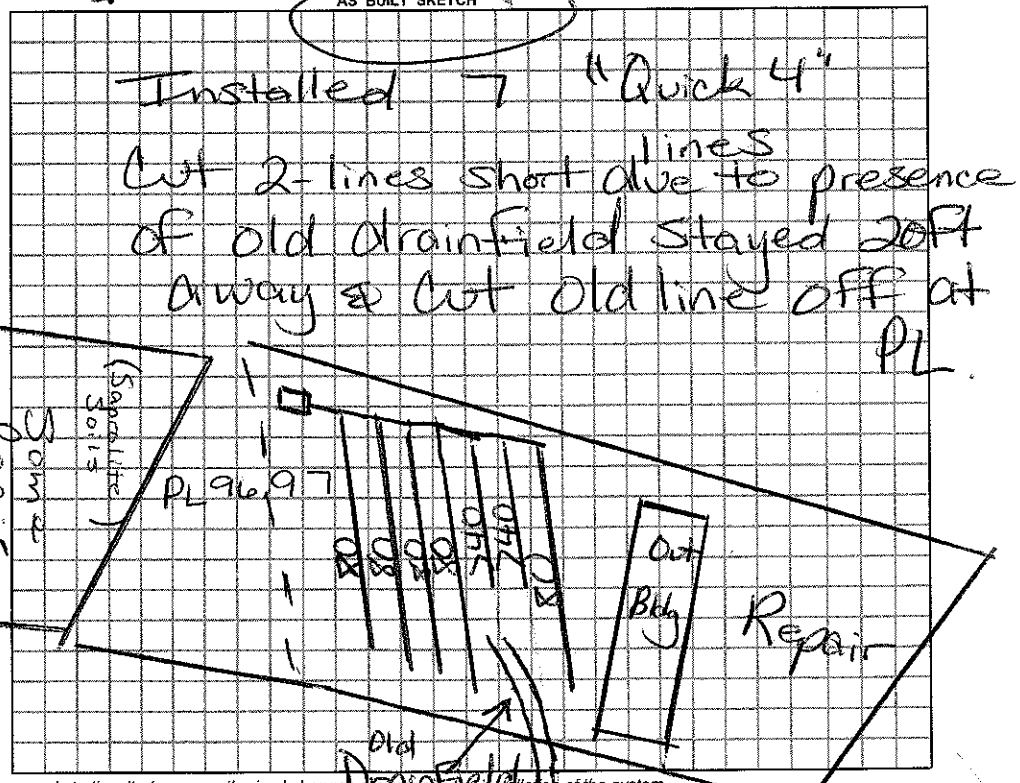

Permit can be suspended or revoked if any false information is supplied toward securing the permit / any unauthorized changes are made to the site / any unauthorized changes are made in the installation of the system.

☐ IMPROVEMENT PERMIT w / plat valid without expiration. ☐ IMPROVEMENT PERMIT w / site plan valid for 60 mos. ☐ AUTHORIZATION TO CONSTRUCT valid for period equal to IMPROVEMENT PERMIT-not to exceed 60

Owner / Applicant Signature: Eric Rollins Date 3-3-09

Improvement Permit by: Marian H. Dotson RS Date 2/25/09

Authorization to Construct by: Marian H. Dotson RS Date 2/25/09

Installed by: A-1 Backhoe

Operation Permit by: Marian H. Dotson RS Date

Existing System Inspected by: ____

YOU SHOULD CONTACT A LOCATOR SERVICE PRIOR TO ANY EXCAVATION.

WHITE COPY Environmental Health YELLOW COPY (Final) Owner / Applicant PINK