4659750795

IREDELL COUNTY HEALTH DEPARTMENT

STATESVILLE 704-878-5305 MOORESVILLE 704-664-5281

IMPROVEMENT PERMIT / CERTIFICATE OF COMPLETION / OPERATION PERMIT / EXISTING SYSTEM INSPECTION

PROPERTY DESCRIPTION NO. 19795 DATE 12/19/94 TAX MAP NO. 4D-1-A-19 Watershed: ☐ Yes ☑ No

OWNER OR CONTRACTOR Danny Luffman PHONE: Business _____ Home 662-6134

ADDRESS 113 E. Dunsby Rd. Mooresville, NC. 28115

LOCATION Shepard Rd (SR) off 115 N, TL 8 miles to 6th lot on R

SUBDIVISION Shepherds Field BLOCK / SECTION 1 LOT 19 LOT AREA ~1.3 Ac. SITE CLASS. P DESIGN FLOW 360 L.T.A.R. .3

Septic Tank: 1000 Gallons; STB 825 Date 1/1/95

Pump Tank: _____ Gallons; PT _____ Date _____

Pump Make: _____ Model 1 Serial No. _____

Nitrification Field: No Fields 1 Square Feet 1200 Linear Feet 400

No Lines 4 Trench Width 1 Bio4 Max Trench Bottom Depth 36" Gravel Depth _____

☑ New System ☐ Repair System Type: I, II, III, IV, V, VI

System Description: Conv - Drop Box

Repair System Description: _____

Maintenance Agreement Required: ☐ Yes ☑ No

☑ House/Mod. Home No. Bedrooms 3

☐ Mobile Home No. Bathrooms 2

☐ Business No. Employees _____

☐ Other _____

☐ Slab ☑ Crawl Space ☐ Basement w/plumbing ☐ Basement wo/plumbing


Water Supply: ☑ Individual ☐ Community ☐ Public

Comments:

Comments:

Installed as drawn.

INITIAL SITE SKETCH

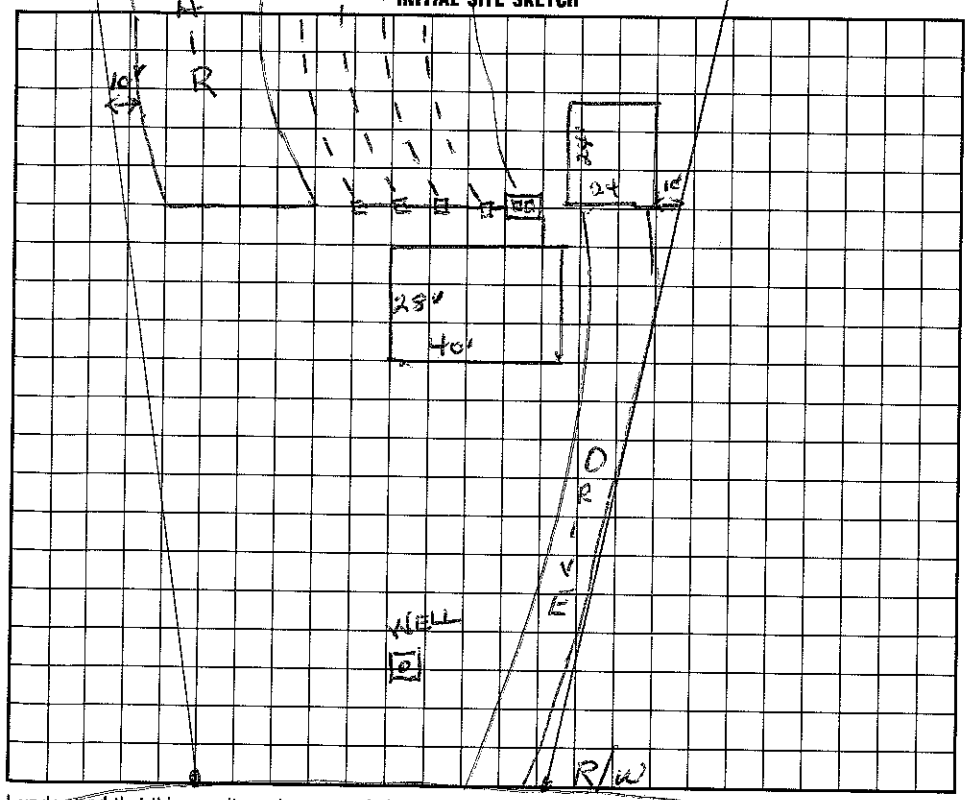

AS BUILT SKETCH

I understand that this permit can be suspended or revoked if any false information is supplied toward securing the permit/any unauthorized changes are made to the site/any unauthorized changes are made in the installation of the system. Improvement Permit is valid for 60 months from date of issuance.

Signed: Danny Luffman

Improvement Permit by: Wesley Sparks R.S. date 12/19/94

Existing System Inspection by: _____ date _____

Installed by: Wayne Ellen

Certificate of Completion by: Wesley Sparks R.S. date 2/13/95

Operation Permit by: _____ date _____

HEALTH DEPT. COPY: WHITE INSPECTION COPY (FINAL): GREEN OWNER COPY (FINAL): YELLOW INSPECTION COPY (INITIAL): PINK OWNER COPY (INITIAL): GOLD