# IREDELL COUNTY HEALTH DEPARTMENT

4659751426

STATESVILLE 704-878-5305 MOORESVILLE 704-664-5281

## IMPROVEMENT PERMIT / CERTIFICATE OF COMPLETION / OPERATION PERMIT / EXISTING SYSTEM INSPECTION

PROPERTY DESCRIPTION NO. 19796 DATE 12/12/94 TAX MAP NO. 4D-1-A-5

OWNER OR CONTRACTOR Norma Luffman Watershed: ☐ Yes ☐ No

ADDRESS PO Box 1337 Mooresville PHONE: Business Home 662-6134

LOCATION Shepards Rd. (R) off 115 N Ti into Shepards Field to 4th mobile Home on (L)

SUBDIVISION Shepards Field BLOCK / SECTION LOT 15 LOT AREA ~1 AC SITE CLASS. P DESIGN FLOW 360 L.T.A.R. .35

Septic Tank: 1000 Gallons; STB 825RST Date 1-2-95

Pump Tank: Gallons; PT Date

Pump Make: Model Serial No.

Nitrification Field: No Fields 1 Square Feet 1058 Linear Feet 342

No Lines 3 Trench Width 36" Max Trench Bottom Depth 32" Gravel Depth 12"

☑ New System ☐ Repair System Type: I, (II), III, IV, V, VI

System Description: Conv. - DROP BOXES

Repair System Description: SAME

Maintenance Agreement Required: ☐ Yes ☑ No

☑ House/Mod. Home No. Bedrooms 3

☐ Mobile Home No. Bathrooms 2

☐ Business No. Employees

☐ Other


☐ Slab ☑ Crawl Space ☐ Basement w/plumbing ☐ Basement wo/plumbing

Water Supply: ☑ Individual ☐ Community ☐ Public


Comments: Tricky contours - may use 4th drop box if necessary. Trench depth 32" to trench bottom

Comments: Mobile home not on site or footings dug. Mobile must be set up at least 5' minimum from septic system - Well not installed as of 2-7-95. NRH

### INITIAL SITE SKETCH

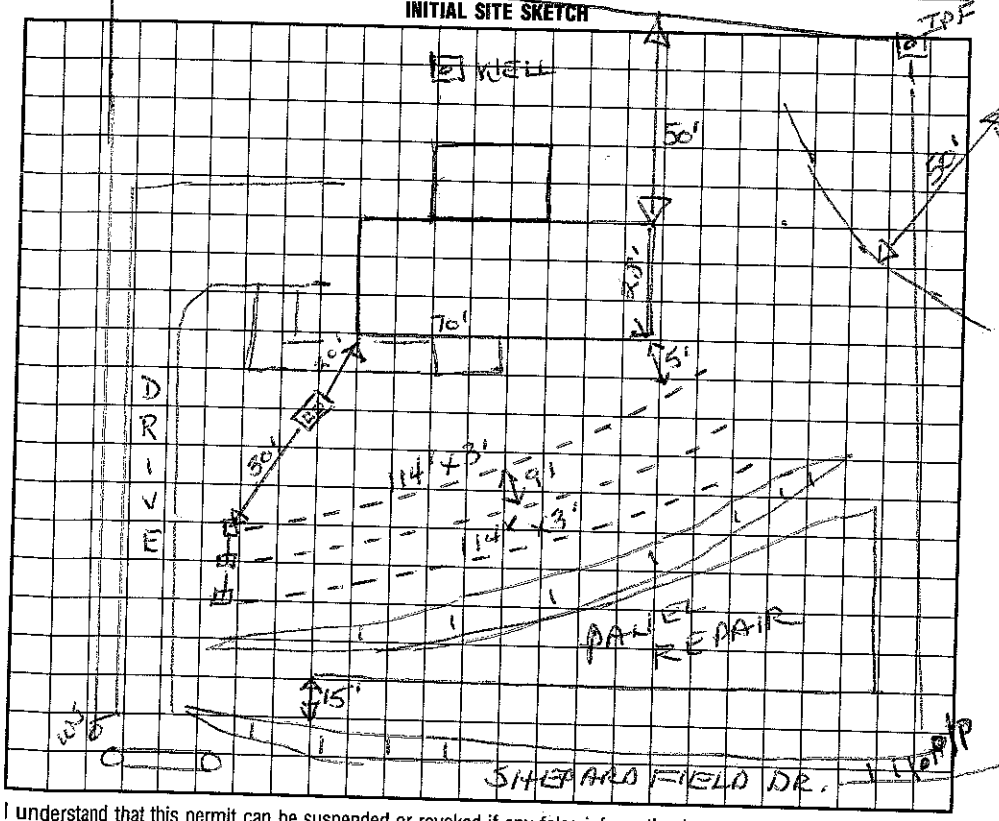


### AS BUILT SKETCH

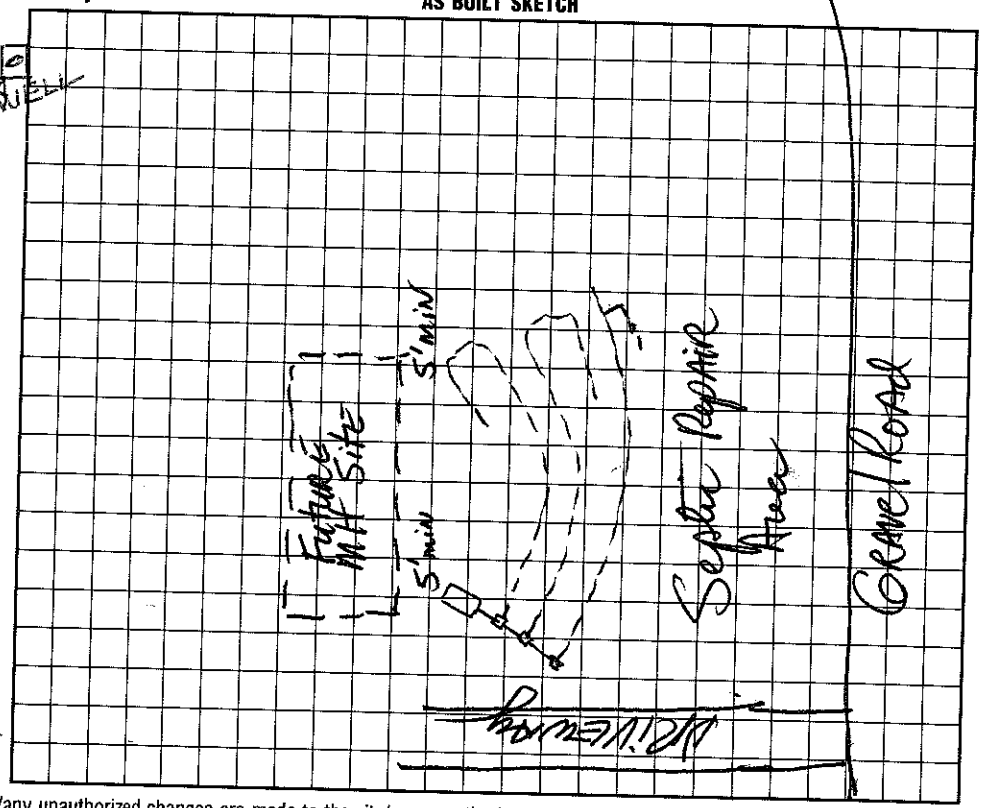


I understand that this permit can be suspended or revoked if any false information is supplied toward securing the permit/any unauthorized changes are made to the site/any unauthorized changes are made in the installation of the system. Improvement Permit is valid for 60 months from date of issuance.

Signed: Norma Luffman

Improvement Permit by: Wesley Sparks RS. date 12/12/94

Existing System Inspection by: date

Installed by: Wayne Ellen

Certificate of Completion by: date 2-7-95

Operation Permit by: date

HEALTH DEPT. COPY: WHITE INSPECTION COPY (FINAL): GREEN OWNER COPY (FINAL): YELLOW INSPECTION COPY (INITIAL): PINK OWNER COPY (INITIAL): GOLD