IREDELL COUNTY HEALTH DEPARTMENT

STATESVILLE 704-878-5305 MOORESVILLE 704-664-5281

IMPROVEMENT PERMIT / AUTHORIZATION TO CONSTRUCT / OPERATION PERMIT / EXISTING SYSTEM INSPECTION

PERMIT# 104445 PIN# ~~4659-92-5352.70~~ 4659-~~81~~-9978 DATE July 9, 02

OWNER OR CONTRACTOR KFS Investments / Lyle E. Calkins PHONE: Business Home

ADDRESS 149 Yacht Cove Ln. Mooresville 28117

LOCATION 115-21N TR Statesville Rd TL Brookglen Dr. on Lft

SUBDIVISION Brookglen BLOCK / SECTION 2 LOT 10 LOT AREA .69 Ac SITE CLASS. 5 DESIGN FLOW 360gpd L.T.A.R. .3

Septic Tank: 1000 Gallons; STB 794 Date 2/25/03
Pump Tank: Gallons; PT Date
Pump Make: Model Serial No.
Nitrification Field: No Fields 1 Square Feet 1200 Linear Feet 400
No Lines 4 Trench Width 36" Trench Bottom Depth 36" Gravel Depth 12"

☑ New System ☐ Repair System Type: I II III IV V VI
System Description: Gravity Conventional
Repair System Description: Stone
Maintenance Agreement Required: ☐ Yes ☑ No


☑ House/Mod. Home No. Bedrooms 3
☐ Mobile Home No. Bathrooms 2
☐ Business No. Employees
☐ Other
☐ Slab ☑ Crawl Space ☐ Basement w/plumbing ☐ Basement wo/plumbing

Water Supply: ☑ Individual ☐ Public ☐ Community

Comments:/Conditions: Install laterals at 36" trench bottom depth. Remove any old burma furnaces in septic system area.

Comments:/Conditions:

INITIAL SITE SKETCH

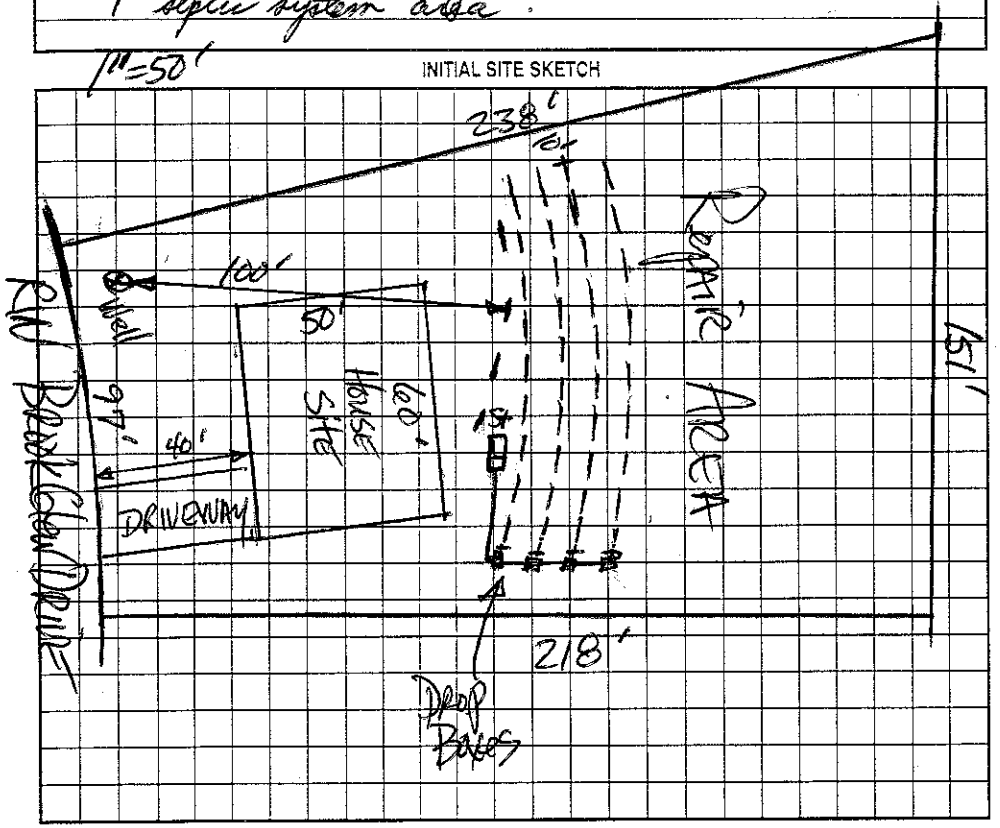

AS BUILT SKETCH

Installed As Drawn

Permit can be suspended or revoked if any false information is supplied toward securing the permit/any unauthorized changes are made to the site/any unauthorized changes are made in the installation of the system. Improvement Permit with plat valid without expiration. Improvement Permit with site plan valid for sixty months. Authorization to Construct is valid for a period equal to that of Improvement Permit – not to exceed sixty months.

Signed: date 8-5-02 Installed by: Christenbury

Improvement Permit by: RS date 7-9-02 Operation Permit by: RS date 4/30/03

Authorization to Construct by: RS date 2/21/03 Existing System Inspection by: date

HEALTH DEPT. COPY: WHITE OWNER COPY (FINAL): YELLOW OWNER COPY (INITIAL): PINK