IREDELL COUNTY HEALTH DEPARTMENT

Statesville Office (704) 878-5305 Mooresville Office (704) 660-3625 PERMIT # 205896

IMPROVEMENT PERMIT / AUTHORIZATION TO CONSTRUCT / OPERATION PERMIT / EXISTING SYSTEM

PIN # 4659-82-3752

APPLICANT: Gauvain Wood APPLICANT ADDRESS: PO Box 3965 Mooresville NC

SITE ADDRESS: 152 Roseland Ct PHONE: ALT. PHONE:

SITE DIRECTIONS: Hwy 115/21 N, TR on Shepherd Rd, TR on Roseland Ct, Lot on R before end

SUBDIVISION: Roseland Heights SECTION: LOT # 57 LOT AREA: 0.37 ac DESIGN FLOW: 360 gpd L.T.A.R.: 0.35

Septic Tank EXISTING (gal) STB Date
Pump Tank EXISTING (gal) PT Date
Pump Make Myers Model ME 50 Serial #
Nitrification Fields 1 # Lines 2 Linear Ft: 125'
Trench Width 36" Max. Trench Bottom Depth 36" Gravel Depth N/A

☑ New System ☐ Repair ☐ Expansion System Type: I II III IV V VI
System Description: EXISTING CONV + 25% Reduction
Repair System Description: LP PPBPS
Maintenance Agreement Required: ☐ YES ☑ NO ☐ GRAVITY ☑ PRESSURE


☑ Residence No. Bedrooms 3
☐ Business No. Persons 6
☐ Other No. Employees
☑ Slab ☐ Crawl Space
☐ Basement w/plumbing ☐ Basement w/o plumbing

Water Supply: ☑ Private ☐ Public ☒ Community


Comments / Conditions: Install new 25% Reduction Lines and divid flow between new lines and existing WITH a Pressure Manifold. CALL WITH QUESTIONS.

6/24/15 Checked 2 new drainlines
7/21/15 Checked pressure, elect & alarm

INITIAL SITE SKETCH

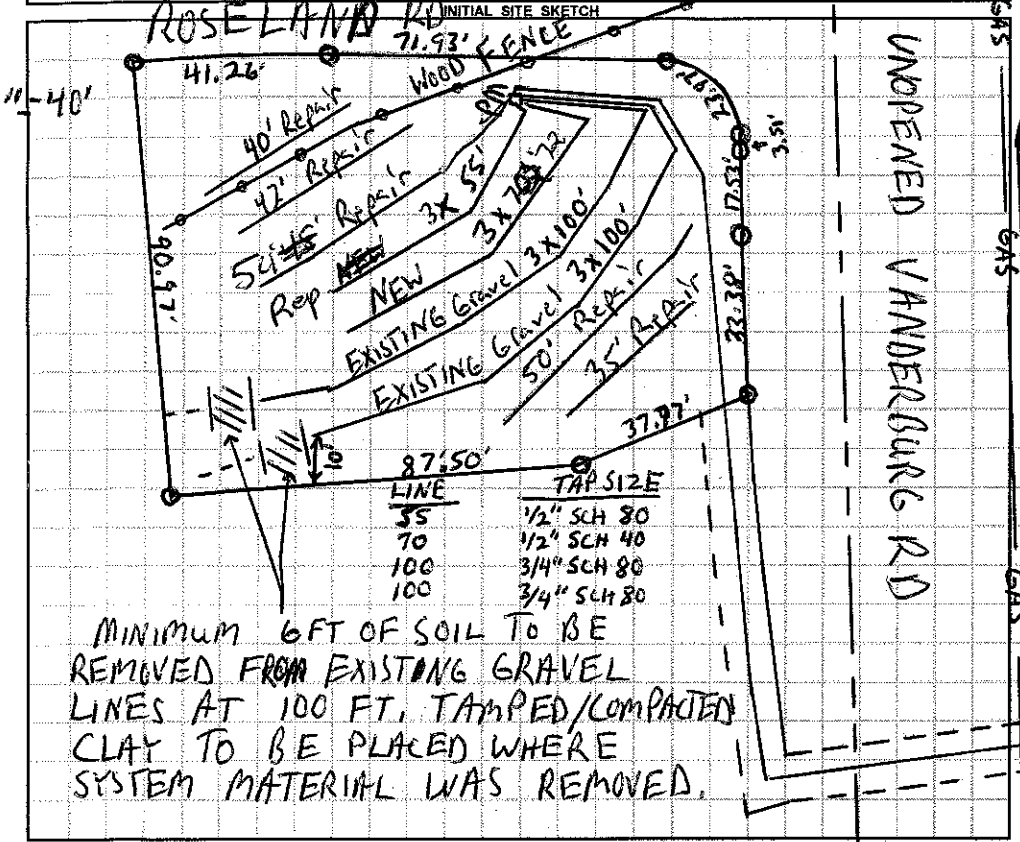

AS BUILT SKETCH

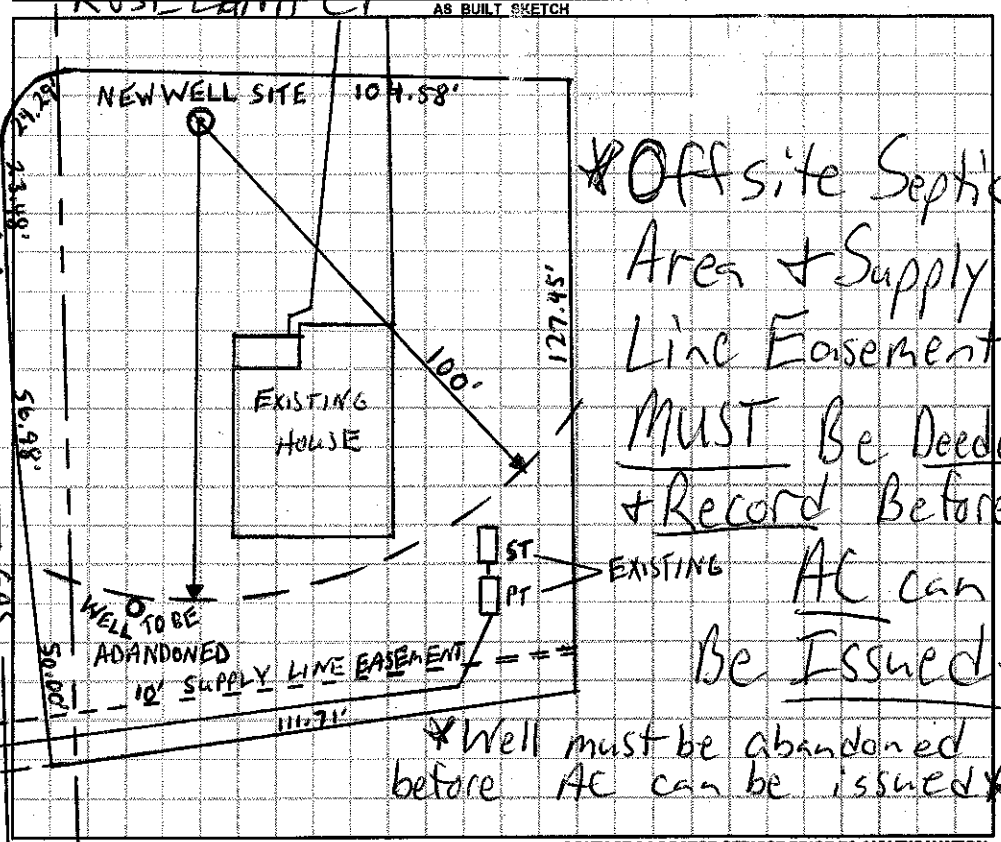

Permit can be suspended or revoked if any false information is supplied toward securing the permit / any unauthorized changes are made to the site / any unauthorized changes are made in the installation of the system. **CONTACT A LOCATOR SERVICE PRIOR TO ANY EXCAVATION**

☐ **IMPROVEMENT PERMIT** *with plat valid without expiration.* ☒ **IMPROVEMENT PERMIT** *with site plan valid for 60 mos.* ☒ **AUTHORIZATION TO CONSTRUCT** *valid for period equal to IMPROVEMENT PERMIT--not to exceed 60 mo.*

Owner / Applicant Signature: Date: 9/24/14 Installed by: R&H

IMPROVEMENT PERMIT by: Date: 9-13-14 OPERATION PERMIT by: Date: 7/21/15

AUTHORIZATION TO CONSTRUCT by: Date: 5-21-15 Existing System Inspected by: Date:

Health Dept. Copy - WHITE Applicant (Final Approval) - YELLOW Applicant (Conditional Approval) - PINK