IREDELL COUNTY HEALTH DEPARTMENT

STATESVILLE 704-878-5305 MOORESVILLE 704-664-5281

IMPROVEMENT PERMIT / AUTHORIZATION TO CONSTRUCT / OPERATION PERMIT / EXISTING SYSTEM INSPECTION

PERMIT # 149372 PIN # 4659823752 DATE 11/23/2010

OWNER or APPLICANT Spear Builders PHONE: Business 7042024964 Home:

OWNER or APPLICANT ADDRESS 172 Allendale Circle Troutman, NC 28166

LOCATION / DIRECTIONS Hwy 21 N TR Shepherd Rd TR Roseland Ct near end on RT

SUBDIVISION Roseland Hts BLOCK / SECTION LOT # 57 LOT AREA .465AC DESIGN FLOW 360 L.T.A.R. .4

Septic Tank 1000 Gallons: STB 825 Date 10-2-10 ☒ New System ☐ Repair ☐ Expansion System Type I II (III) IV V VI

Pump Tank 1000 Gallons: PT 302 Date 9-11-10 System Description: Pump - 25% Reduction

Pump Make Zoeller Model N152 Serial # Repair System Description: Pump-LP-Panel Blk

Nitrification Field No Fields 1 No Lines 5 Linear Feet 275' Maintenance Agreement Required ☐ YES ☐ NO

Trench Width 36" Max. Trench Bottom Depth 36" Gravel Depth N/A ☐ GRAVITY ☒ PRESSURE

☒ Residence No. Bedrooms 3 Water Supply

☐ Business No. Persons ☒ Private

☐ Other No. Employees ☐ Public

☐ Slab ☐ Crawl Space ☐ Community


☐ Basement w/plumbing ☐ Basement w/o plumbing

Comments / Conditions Maintain at least 20ft btw Drainfield areas for Lot 57 & 58


Comments / Conditions This permit replaces previous permit from 7/21/08 due to drive installed in original repair area. Used Quick4 11/29/2010

INITIAL SITE SKETCH

Scale 1"=40

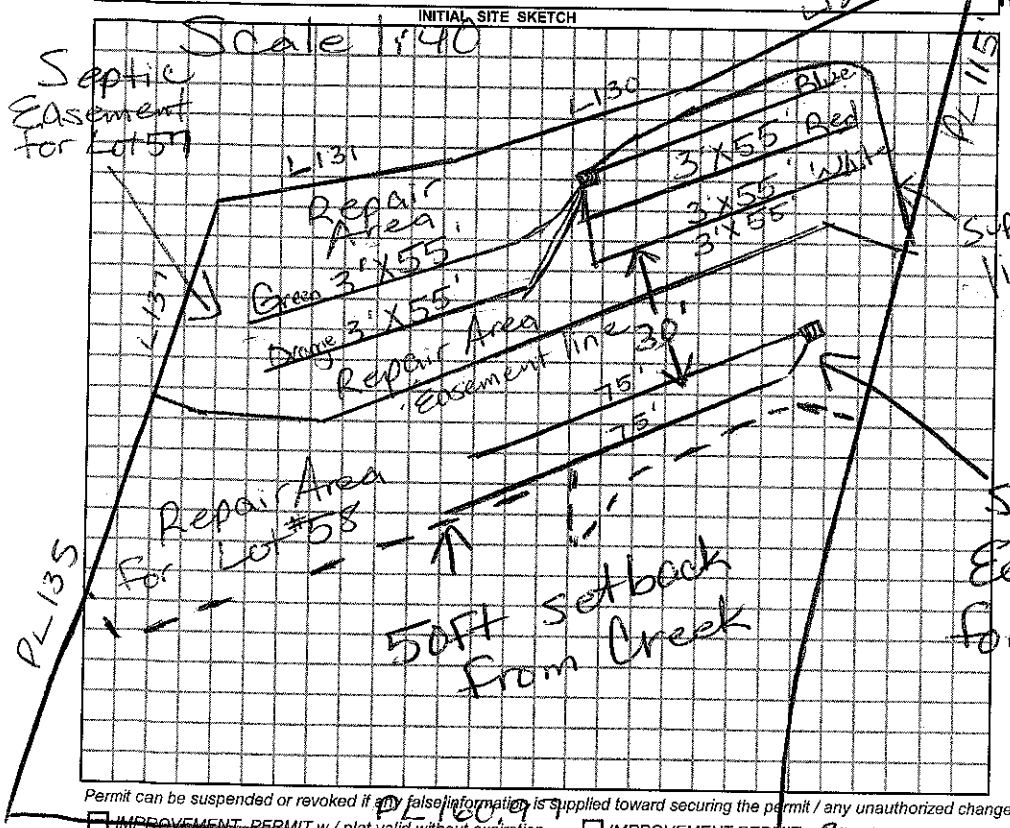

AS BUILT SKETCH

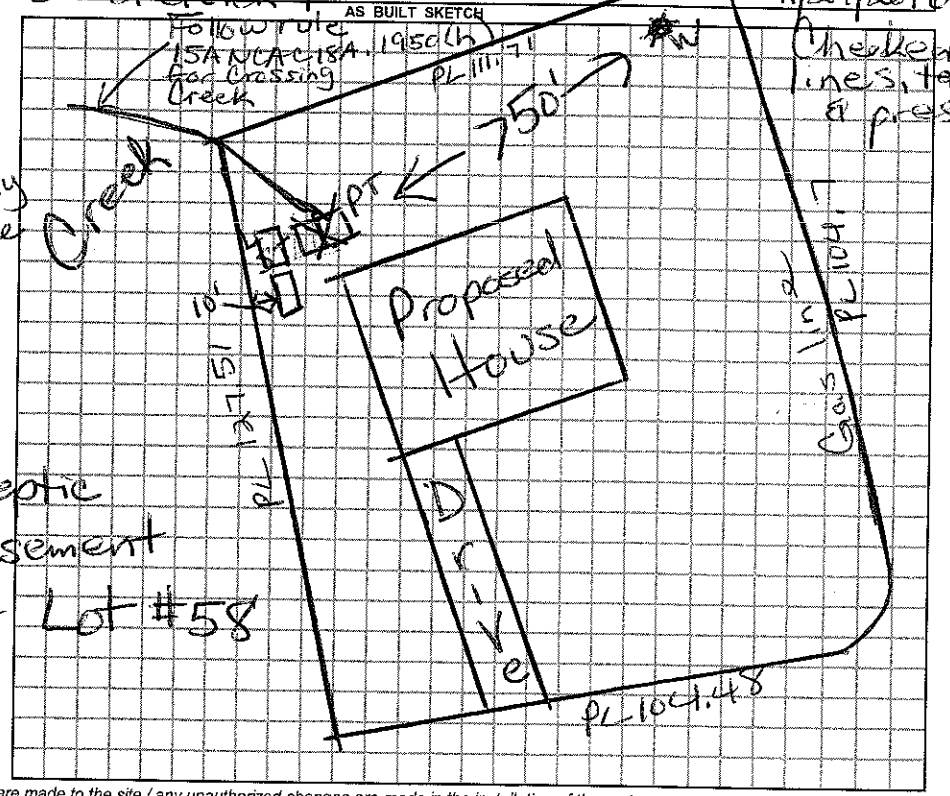

Permit can be suspended or revoked if any false information is supplied toward securing the permit / any unauthorized changes are made to the site / any unauthorized changes are made in the installation of the system.

☐ IMPROVEMENT PERMIT w / plat valid without expiration. ☐ IMPROVEMENT PERMIT w / site plan valid for 60 mos. ☐ AUTHORIZATION TO CONSTRUCT valid for period equal to IMPROVEMENT PERMIT-not to exceed 60 mo.

Owner / Applicant Signature: Date 11/29/10 Installed by: Rowan Septic

Improvement Permit by: RS Date 11/23/2010 Operation Permit by: Date: 12/13/2010

Authorization to Construct by: RS Date 11/23/2010 Existing System Inspected by: Date:

YOU SHOULD CONTACT A LOCATOR SERVICE PRIOR TO ANY EXCAVATION!

WHITE COPY Environmental Health YELLOW COPY (Final) Owner / Applicant PINK COPY (Initial) Owner / Applicant