IREDELL COUNTY HEALTH DEPARTMENT

Statesville Office (704) 873-5305 Mooresville Office (704) 660-3625 PERMIT # 205895

IMPROVEMENT PERMIT / AUTHORIZATION TO CONSTRUCT / OPERATION PERMIT / EXISTING SYSTEM

PIN # 4659-82-4758

APPLICANT: Gauvain Wood APPLICANT ADDRESS: PO Box 3365 Mooresville NC

SITE ADDRESS: 158 Roseland Ct PHONE: ALT. PHONE:

SITE DIRECTIONS: Hwy 115/21 N, TR on Shepherd Rd, TR on Roseland Ct, Lot at end on R

SUBDIVISION: Roseland Heights SECTION: LOT # 58 LOT AREA: 0.36ac DESIGN FLOW: 360gpd L.T.A.R.: 0.3

Septic Tank 1000 (gal) STB Date
Pump Tank 1000 (gal) PT Date
Pump Make Zoeller Model N152 Serial #
Nitrification Fields 1 # Lines 4 Linear Ft: 200'
Trench Width 24" min. Max. Trench Bottom Depth 36" Gravel Depth N/A

☑ New System ☐ Repair ☐ Expansion System Type: I II III IV V VI
System Description: PM PPBPS
Repair System Description: LP PPBPS
Maintenance Agreement Required: ☐ YES ☑ NO
☐ GRAVITY ☑ PRESSURE

☑ Residence No. Bedrooms 3
☐ Business No. Persons 6
☐ Other No. Employees
☑ Slab ☐ Crawl Space
☐ Basement w/plumbing ☐ Basement w/o plumbing

Water Supply
☒ Private
☐ Public
☒ Community

Comments / Conditions: Existing ST & PT to be abandoned by pumping, crushing and backfilling.


9/24/15 Checked new drainlines
9/21/15 Checked pressure, elect & alarm

INITIAL SITE SKETCH



AS BUILT SKETCH

1"=50' ✗ DO NOT ISSUE AC BEFORE OFFSITE SEPTIC AREA + SUPPLY LINE EASEMENT HAS BEEN DEEDED AND RECORDED. ✗

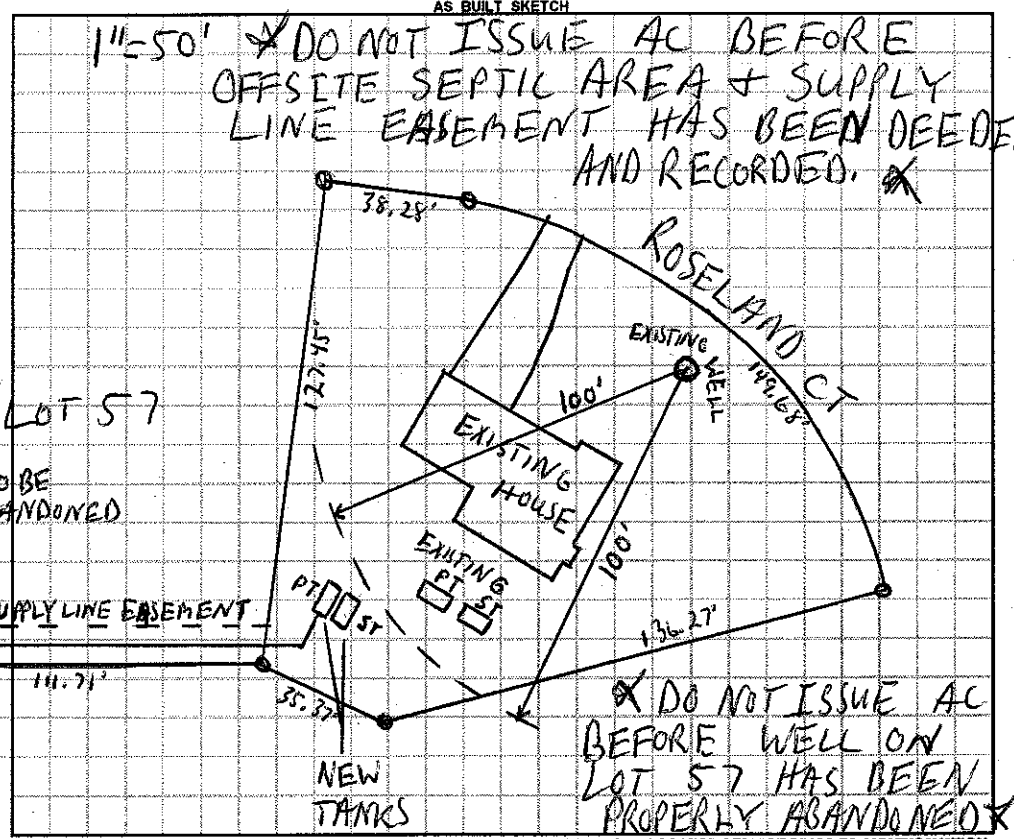

✗ DO NOT ISSUE AC BEFORE WELL ON LOT 57 HAS BEEN PROPERLY ABANDONED ✗

Permit can be suspended or revoked if any false information is supplied toward securing the permit / any unauthorized changes are made to the site / any unauthorized changes are made in the installation of the system. **CONTACT A LOCATOR SERVICE PRIOR TO ANY EXCAVATION**

☐ **IMPROVEMENT PERMIT** *with plat valid without expiration.* ☒ **IMPROVEMENT PERMIT** *with site plan valid for 60 mos.* ☑ **AUTHORIZATION TO CONSTRUCT** *valid for period equal to IMPROVEMENT PERMIT--not to exceed 60 mo.*

Owner / Applicant Signature: Date: 9-26-14 Installed by:

IMPROVEMENT PERMIT by: Date: 9-13-14 OPERATION PERMIT by: Date: 7/21/15

AUTHORIZATION TO CONSTRUCT by: Date: APPROVED MAY 15 2015 Existing System Inspected by: Date:

Health Dept. Copy - WHITE Applicant (Final Approval) - YELLOW Applicant (Conditional Approval) - PINK