ques 365.00 + ques 4

IREDELL COUNTY HEALTH DEPARTMENT

STATESVILLE 704-878-5305 MOORESVILLE 704-664-5281

IMPROVEMENT PERMIT / AUTHORIZATION TO CONSTRUCT / OPERATION PERMIT / EXISTING SYSTEM INSPECTION

PERMIT# 151620 PIN# 4659824758.000 DATE 7/21/08

OWNER OR APPLICANT Spears Builders Inc PHONE: Business 704361-7518 Home

ADDRESS 172 Allendale Cir. Troutman NC 28166

LOCATION 21 N TR Shepherd Rd TR Roseland Ct Near end on (R) 8th lot on Right

SUBDIVISION Roseland Heights BLOCK / SECTION LOT 58 LOT AREA 1.36 SITE CLASS. PS DESIGN FLOW 360 L.T.A.R. 0.4

Septic Tank: 1000 Gallons; STB 825 Date 8-11-10

Pump Tank: 1000 Gallons; PT 302 Date 9-13-10

Pump Make: Model Serial No.

Nitrification Field: No Fields 1 Square Feet 200 Linear Feet 150'

No Lines 2 @ 75' Trench Width 36" Max Trench Bottom Depth 36" Gravel Depth N/A

☑ New System ☐ Repair ☐ Expansion System Type: I II III IV V VI

System Description: LPP BPS

Repair System Description: Same

Maintenance Agreement Required: ☑ Yes ☐ No

☑ House/Mod. Home ☐ Mobile Home ☐ Business ☐ Other

No. Bedrooms 3 No. Persons No. Employees

Water Supply: ☑ Individual ☐ Public ☐ Community

☐ Gravity ☑ Pressure ☑ Slab ☐ Crawl Space ☐ Basement w/plumbing ☐ Basement wo/plumbing

Comments:/Conditions: System to be pumped accross creek
Contact Health Dept. for approved creek crossing methods
~~Depending on footage~~


Comments:/Conditions: 8/11/08 Reviewed Floor plans in compliance with original permit
11/18/2010 Checked tanks & Supply line
11/18/2010 Checked lines & set pressure

INITIAL SITE SKETCH

System is to be pumped to offsite basement.
Have basement lot recorded & submit plat & plan before AC can be issued.

See Plan by Rollins Soil Env. comment by Services, Inc.

AS BUILT SKETCH

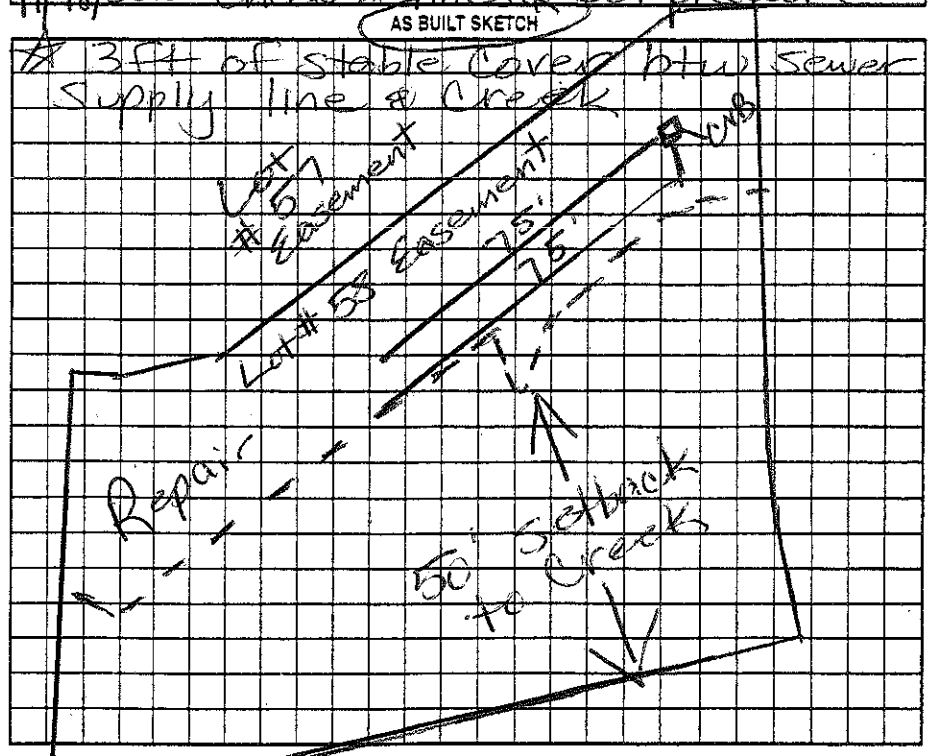

Permit can be suspended or revoked if any false information is supplied toward securing the permit/any unauthorized changes are made to the site/any unauthorized changes are made in the installation of the system. Improvement Permit with plat valid without expiration ☐ Improvement Permit with site plan valid for sixty months ☑ Authorization to Construct is valid for a period equal to that of Improvement Permit – not to exceed sixty months.

Signed: date 8/1/08

Improvement Permit by: Kathleen Coty RS date 7/21/08

Authorization to Construct by: Maria H Dotson RS date 8/11/08

Installed by: Rowan Septic

Operation Permit by: Maria H Dotson date 12/13/2010

Existing System Inspection by: date

HEALTH DEPT. COPY: WHITE OWNER COPY (FINAL): YELLOW OWNER COPY (INITIAL): PINK