3108

IREDELL COUNTY HEALTH DEPARTMENT

STATESVILLE 704-878-5305 MOORESVILLE 704-664-5281

IMPROVEMENT PERMIT / AUTHORIZATION TO CONSTRUCT / OPERATION PERMIT / EXISTING SYSTEM INSPECTION

PERMIT# 104446 PIN# ~~4659-92-5352.71~~ 4659829059 DATE ~~July 10, 02~~

OWNER OR CONTRACTOR KFS, Investments / Calkins Construct. PHONE: Business _____ Home _____

ADDRESS 149 Yacht Cove Ln. / Mooresville 28117

LOCATION 115-21 N. TR Shinnville Rd TL Brookglen Dr. on left

SUBDIVISION Brookglen BLOCK / SECTION 2 LOT 71 LOT AREA .57Ac SITE CLASS PS DESIGN FLOW 360gpd L.T.A.R. .25±

Septic Tank: 1000 Gallons; STB 312 Date 2-28-05
Pump Tank: 1000 Gallons; PT 283 Date 2-28-05
Pump Make: Zoeller Model 152 Serial No. _____
Nitrification Field: No Fields 1 Square Feet 960 Linear Feet 320
No Lines 4 Trench Width 36" Trench Bottom Depth 36" Gravel Depth NA

☑ New System ☐ Repair System Type: I, II, III, IV, V, VI
System Description: PM - 25% Reduction
Repair System Description: LPPBPS
Maintenance Agreement Required: ☐ Yes ☑ No

☑ House/Mod. Home No. Bedrooms 3
☐ Mobile Home No. Bathrooms 2
☐ Business No. Employees _____
☐ Other _____

☐ Slab ☑ Crawl Space ☐ Basement w/plumbing ☐ Basement wo/plumbing


Water Supply: ☑ Individual ☐ Public ☐ Community

Comments:/Conditions: Install Laterals at 36" trench bottom depth. Remove any old burms terraces in septic system area.

Comments:/Conditions: Reviewed Building plans, essentially in compliance with original permit. Press, dist & alarm 5/12/05

1"=50'

INITIAL SITE SKETCH

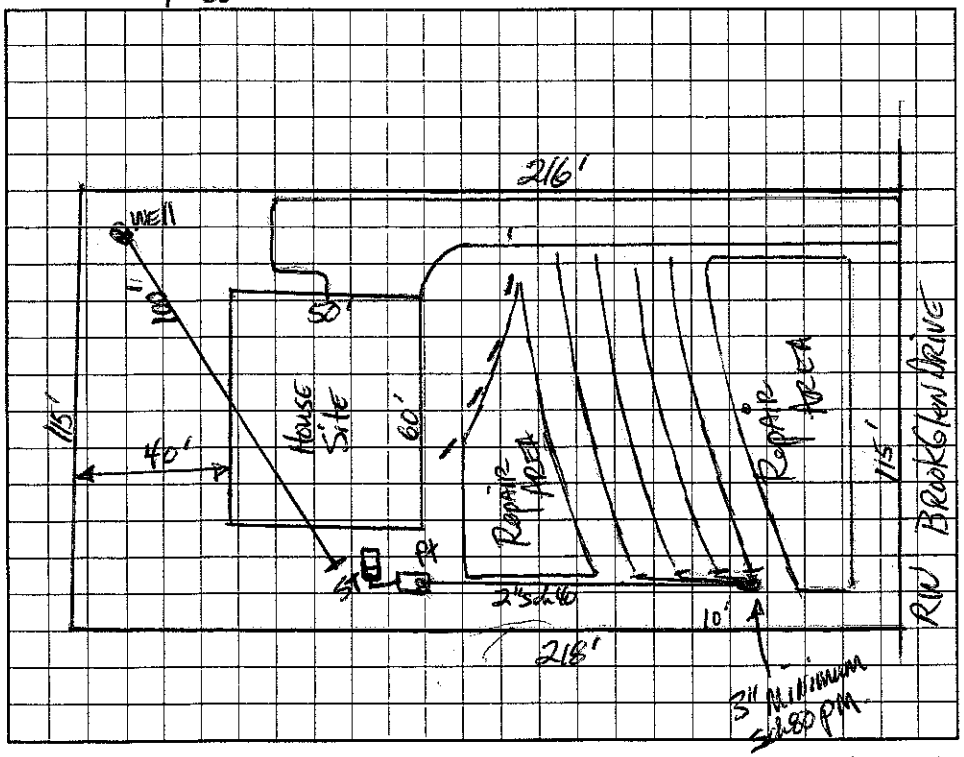

AS BUILT SKETCH

EZ Flow Installed as Drawn

Permit can be suspended or revoked if any false information is supplied toward securing the permit/any unauthorized changes are made to the site/any unauthorized changes are made in the installation of the system. Improvement Permit with plat valid without expiration. Improvement Permit with site plan valid for sixty months. Authorization to Construct is valid for a period equal to that of Improvement Permit – not to exceed sixty months.

Signed: _____ date 8-9-02 Installed by: Willie Christenbury

Improvement Permit by: _____ date 7-10-02 Operation Permit by: _____ date 5/12/05

Authorization to Construct by: _____ date 12/9/04 Existing System Inspection by: _____ date _____

HEALTH DEPT. COPY: WHITE OWNER COPY (FINAL): YELLOW OWNER COPY (INITIAL): PINK