IREDELL COUNTY HEALTH DEPARTMENT

STATESVILLE 704-878-5305 50.00 Pd 9 MOORESVILLE 704-664-5281 12108

IMPROVEMENT PERMIT / AUTHORIZATION TO CONSTRUCT / OPERATION PERMIT / EXISTING SYSTEM INSPECTION

PERMIT# 104453 PIN# 4659925352 76 4659-82-9756, 7992976 DATE 9-19-03

OWNER OR CONTRACTOR KFS Investments/ES Johnson PHONE: Business ES Johnson Home

ADDRESS 149 Yacht Cove Ln Mooresville, NC 28117

LOCATION 115 & 21 N TR Shinnville TL Brookglen Dr on left

SUBDIVISION Brookglen BLOCK / SECTION 2 LOT 76 LOT AREA .95 SITE CLASS. PS DESIGN FLOW 360gpd L.T.A.R. .2-.25

Septic Tank: 1000 Gallons; STB 794 Date 9-23-03
Pump Tank: 1600 Gallons; PT 283 Date 9-24-03
Pump Make: Zoeller Model 153 Material No.
Nitrification Field: No. Fields 1 Square Feet 1350' Linear Feet 450'
No Lines 5@90' Trench Width 36" Max Trench Bottom Depth 24" Gravel Depth N/A

[X] New System [ ] Repair System Type: I, II, III, IV, V, VI
System Description: Pump-PM-25% Reduction
Repair System Description: LPP
Maintenance Agreement Required: [ ] Yes [X] No Not Initially

[X] House/Mod. Home No. Bedrooms 3
[ ] Mobile Home No. Bathrooms 2
[ ] Business No. Employees
[ ] Other

[ ] Slab [X] Crawl Space [ ] Basement w/plumbing [ ] Basement wo/plumbing


Water Supply: [X] Individual [ ] Public [ ] Community

Comments/Conditions: Remove old berms in Septic area. Keep Septic System at least 10' From PL & 100' From well


Comments/Conditions: Note: House location moved from original permit. Checked tanks, lines & ~~plan~~ pressure 11/12/03

Scale 1:50

INITIAL SITE SKETCH

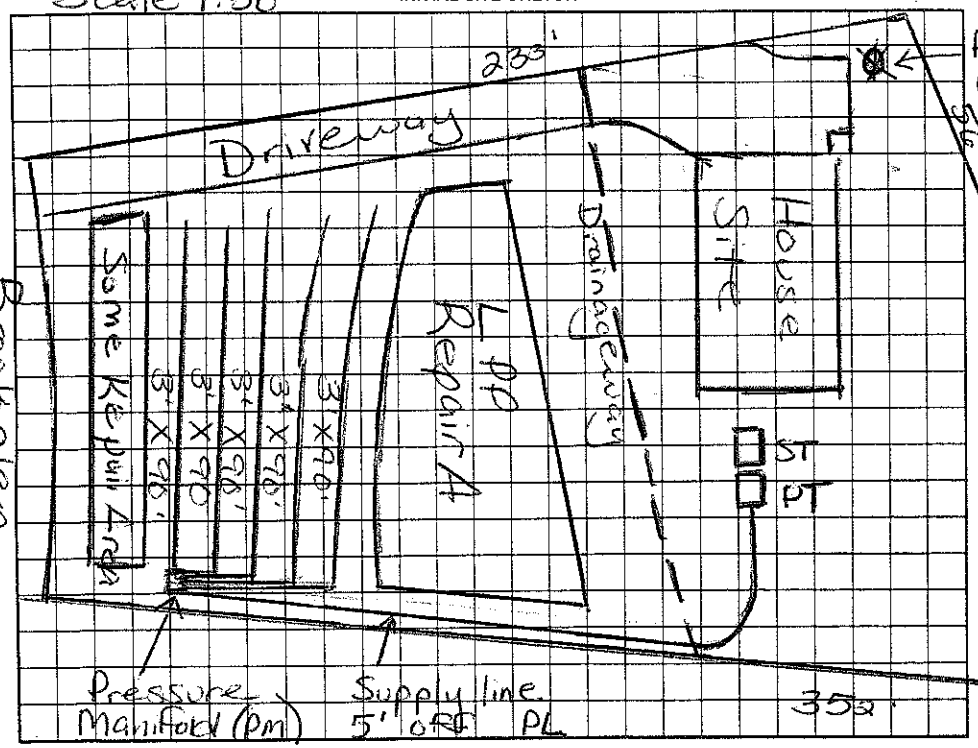

AS BUILT SKETCH

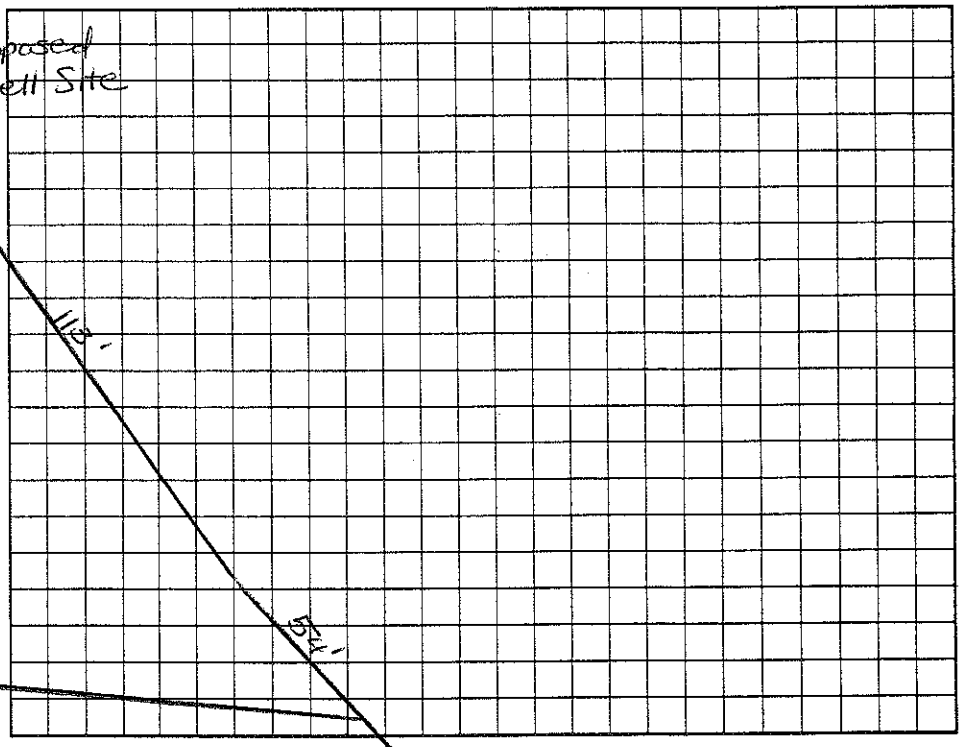

Permit can be suspended or revoked if any false information is supplied toward securing the permit/any unauthorized changes are made to the site/any unauthorized changes are made in the installation of the system. Improvement Permit with plat valid without expiration. Improvement Permit with site plan valid for sixty months. Authorization to Construct is valid for a period equal to that of Improvement Permit – not to exceed sixty months.

Signed: Mac Tate 9/22 date 9/22/03 Installed by: Willie Christenbury

Improvement Permit by: Maina Hill Dotson RS date 9/19/03 Operation Permit by: Maina Hill Dotson RS date 2/6/04

Authorization to Construct by: Maina Hill Dotson RS date 9/19/03 Existing System Inspection by: _____ date _____

HEALTH DEPT. COPY: WHITE OWNER COPY (FINAL): YELLOW OWNER COPY (INITIAL): PINK