IREDELL COUNTY HEALTH DEPARTMENT

STATESVILLE 704-878-5305 MOORESVILLE 704-664-5281

4659855930

IMPROVEMENT PERMIT / CERTIFICATE OF COMPLETION / OPERATION PERMIT / EXISTING SYSTEM INSPECTION

PROPERTY DESCRIPTION NO. 17150 DATE 10/6/93 TAX MAP NO. 4D-A-49

OWNER OR CONTRACTOR SISAVATH SISOUKRATH PHONE: Business Home 664-5650

ADDRESS R4 5 BOX 638-A MOORESVILLE, NC.

LOCATION SHEPARD RD; ~ 3/4 MILE ON (R)

SUBDIVISION No BLOCK / SECTION LOT LOT AREA ~3.8 AC SITE CLASS. P L.T.A.R. .3-.35

Water Supply: ☑ Individual ☐ Community ☐ Public

Septic Tank: 1000 Gallons; STB Date 12/8/92

GREASE Tank: 1000 Gallons; PT Date 12/8/92

Nitrification Field: No Fields 1 Square Feet 450 Linear Feet 150

No Lines 2 Trench Width 3' Trench Depth 36" Gravel Depth 12"

☐ New System ☐ Repair System Type: I, (II), III, IV, V, VI

System Description: CONV.

Repair System Description:

Maintenance Agreement Required: ☐ Yes ☑ No

☐ House/Mod. Home ☐ Mobile Home ☐ Business ☑ Other EXPANSION OF KITCHEN

No. Bedrooms No. Bathrooms No. Employees

Garbage Disposal: ☐ Yes ☑ No

Auto. Dishwasher: ☐ Yes ☑ No

Auto. Washing Machine: ☐ Yes ☑ No

Other 3 EMPLOYEE MAX.


☑ Slab ☐ Crawl Space ☐ Basement w/plumbing ☐ Basement wo/plumbing

Comments

ADDITION OF WALK IN FREEZER AND COOLER, ADDING SMALL COOKING ROOM INSIDE KITCHEN AREA

INITIAL SITE SKETCH

AS BUILT SKETCH

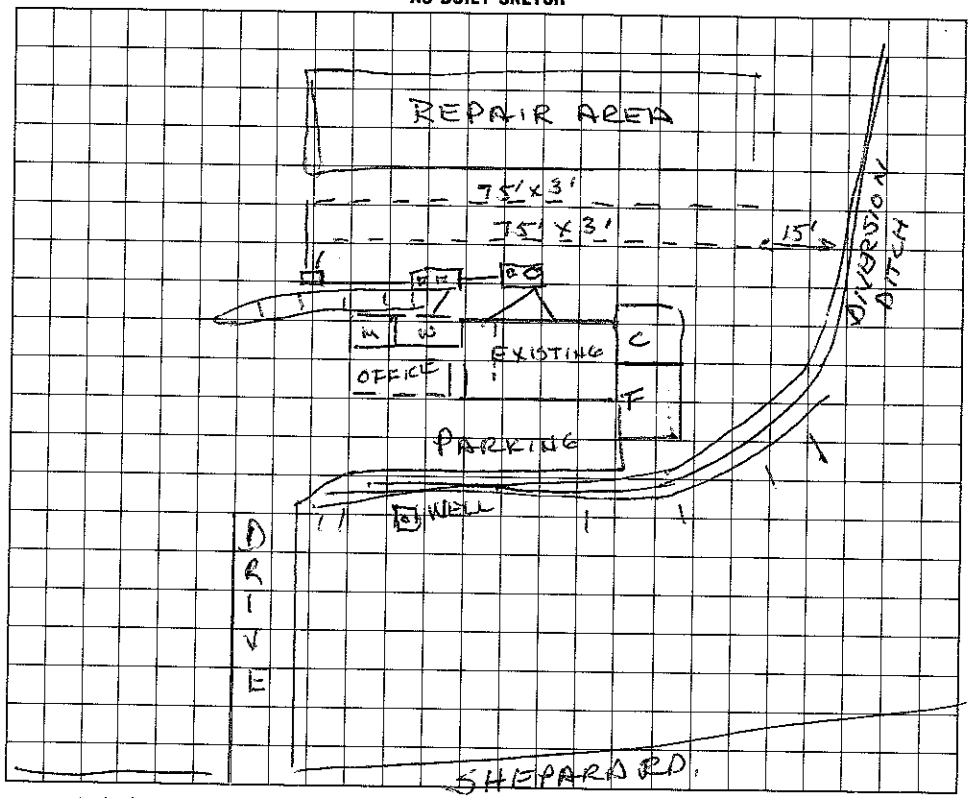

I understand that this permit can be suspended or revoked if any false information is supplied toward securing the permit/any unauthorized changes are made to the site/any unauthorized changes are made in the installation of the system. Improvement Permit is valid for 60 months from date of issuance.

Signed:

Improvement Permit by: date

Existing System Inspection by: Wesley Sparks RS. date 10/6/93

Installed by:

Certificate of Completion by: date

Operation Permit by: date

HEALTH DEPT. COPY: WHITE INSPECTION COPY (FINAL): GREEN OWNER COPY (FINAL): YELLOW INSPECTION COPY (INITIAL): PINK OWNER COPY (INITIAL): GOLD