IREDELL COUNTY HEALTH DEPARTMENT

STATESVILLE 704-878-5305 MOORESVILLE 704-664-5281

IMPROVEMENT PERMIT / AUTHORIZATION TO CONSTRUCT / OPERATION PERMIT / EXISTING SYSTEM INSPECTION

PERMIT # REPAIR PIN # 4659-86-3814 DATE 6-28-12

OWNER or APPLICANT LINDA ALEXANDER PHONE: Business 704-664-4638 Home:

OWNER or APPLICANT ADDRESS 397 SHINNVILLE RD

LOCATION / DIRECTIONS ON L BEFORE SHINNVILLE ESTATES

SUBDIVISION BLOCK / SECTION LOT # LOT AREA 3.93 AC DESIGN FLOW 240 L.T.A.R.

Septic Tank 1000 Gallons: STB 760 Date 2-26
Pump Tank Gallons: P T Date
Pump Make Model Serial #
Nitrification Field No Fields No Lines Linear Feet 233'
Trench Width Max. Trench Bottom Depth Gravel Depth

☐ New System ☐ Repair ☐ Expansion System Type I ☒ II III IV V VI
System Description: TANK
Repair System Description:
Maintenance Agreement Required ☐ YES ☒ NO
☒ GRAVITY ☐ PRESSURE


☒ Residence No. Bedrooms 2
☐ Business No. Persons
☐ Other No. Employees
☐ Slab ☒ Crawl Space
☐ Basement w/plumbing ☐ Basement w/o plumbing

Water Supply: ☒ Private ☐ Public ☐ Community


Comments / Conditions

Comments / Conditions: INSTALL NEW TANK AS SHOWN

INITIAL SITE SKETCH

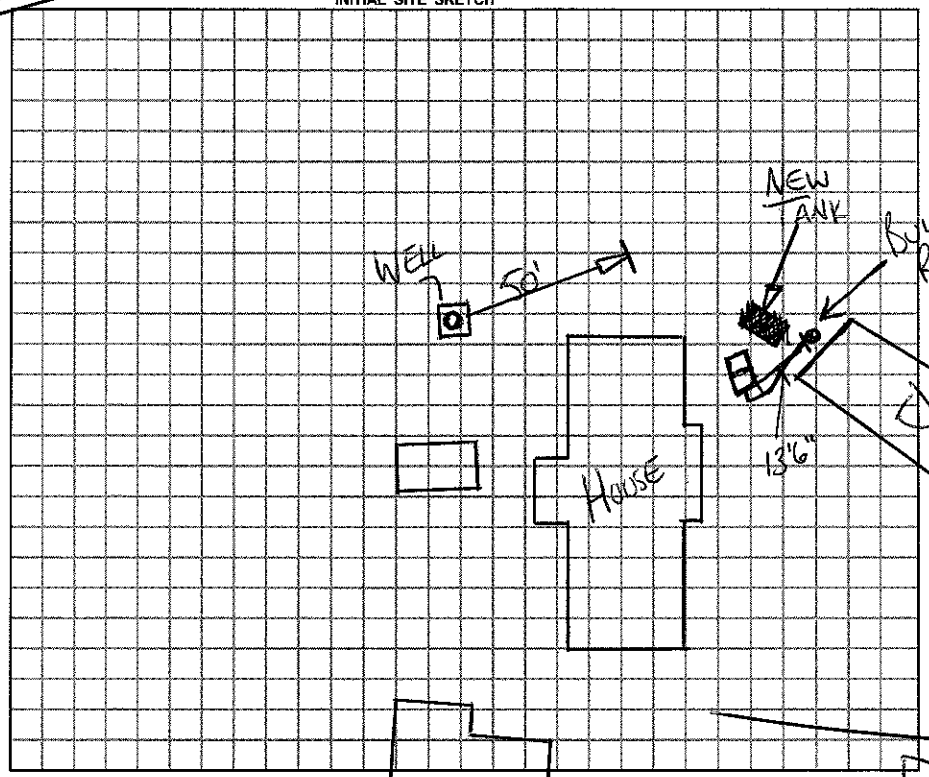

AS BUILT SKETCH

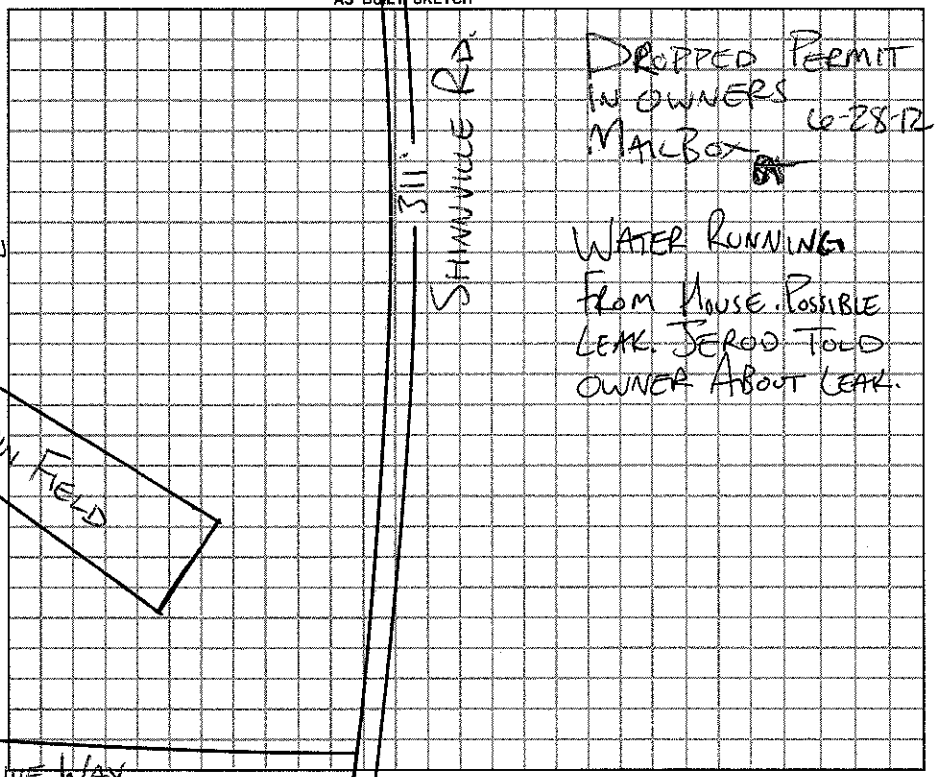

Permit can be suspended or revoked if any false information is supplied toward securing the permit / any unauthorized changes are made to the site / any unauthorized changes are made in the installation of the system.

☐ *IMPROVEMENT PERMIT w / plat valid without expiration.* ☐ *IMPROVEMENT PERMIT w / site plan valid for 60 mos.* ☒ *AUTHORIZATION TO CONSTRUCT valid for period equal to IMPROVEMENT PERMIT-not to exceed 60 mo.*

Owner / Applicant Signature: Date

Improvement Permit by: Date 6-28-12

Authorization to Construct by: Date 6-28-12

YOU SHOULD CONTACT A LOCATOR SERVICE PRIOR TO ANY EXCAVATION.

Installed by: LENTZ

Operation Permit by: REHS Date: 7-3-12

Existing System Inspected by: Date:

WHITE COPY Environmental Health YELLOW COPY (Final) Owner / Applicant PINK COPY (Initial) Owner / Applicant