4659869020

IREDELL COUNTY HEALTH DEPARTMENT

STATESVILLE 704-878-5305 MOORESVILLE 704-664-5281

IMPROVEMENT PERMIT / CERTIFICATE OF COMPLETION / OPERATION PERMIT / EXISTING SYSTEM INSPECTION

PROPERTY DESCRIPTION NO. 23162 DATE March 6, '96 TAX MAP NO. part of 4045 Watershed: ☐ Yes ☐ No

OWNER OR CONTRACTOR M. G. Nantz JR. PHONE: Business _____ Home _____

ADDRESS 218 Shepherd Rd. / Mooresville

LOCATION 115 N TR Shepherd Rd w/ 1 mile on right (just past "Sausage MAN" - Siskawatta)

SUBDIVISION _____ BLOCK / SECTION _____ LOT _____ LOT AREA ~1½ Ac SITE CLASS. PS DESIGN FLOW 360 gpd L.T.A.R. .03

Septic Tank: 1000 Gallons; STB 794 Date 5/3/96
Pump Tank: _____ Gallons; PT _____ Date _____
Pump Make: _____ Model _____ Serial No. _____
Nitrification Field: No Fields 1 Square Feet 1200 Linear Feet 400
No Lines 4@100' Trench Width 36" Max Trench Bottom Depth 24" Gravel Depth 12"

☑ New System ☐ Repair System Type: I (II) III IV V VI
System Description: Shallow quarry conventional
Repair System Description: SAME
Maintenance Agreement Required: ☐ Yes ☑ No


☑ House/Mod. Home No. Bedrooms 3
☐ Mobile Home No. Bathrooms 2
☐ Business No. Employees _____
☐ Other _____
☐ Slab ☑ Crawl Space ☐ Basement w/plumbing ☐ Basement wo/plumbing

Water Supply:
☑ Individual
☐ Community
☐ Public

Comments:
USE D-box w/speed Levelers OR 3 Flow Divider Tees

Comments:
Installed as drawn.

INITIAL SITE SKETCH

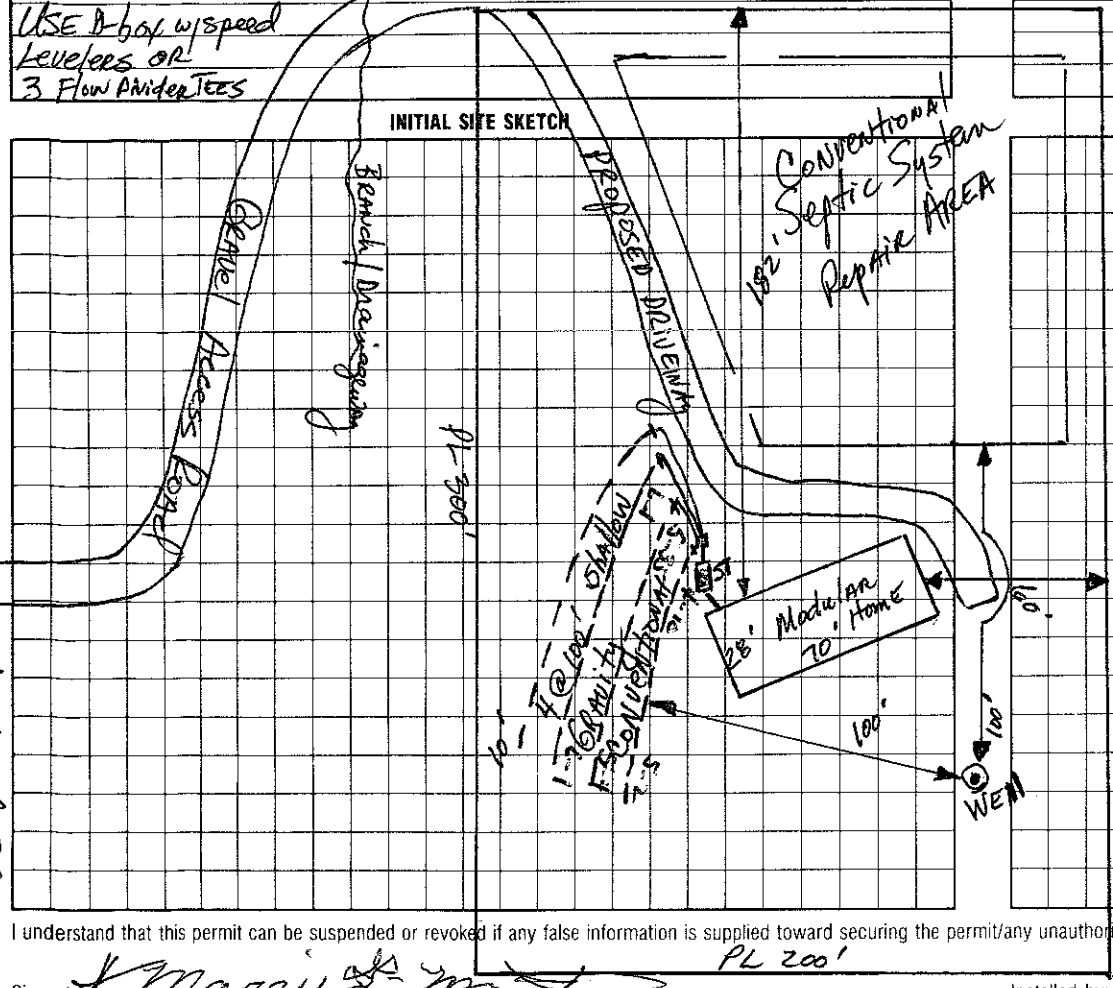

AS BUILT SKETCH

I understand that this permit can be suspended or revoked if any false information is supplied toward securing the permit/any unauthorized changes are made to the site/any unauthorized changes are made in the installation of the system.

Signed: _____

Improvement Permit by: _____ date 3-6-96

Authorization for Eng. System Inspection by: _____ date 3-6-96

Installed by: F J Ervin

Certificate of Completion by: _____ date _____

Operation Permit by: Wesley Sparks R.S. date 6/4/96

HEALTH DEPT. COPY: WHITE INSPECTION COPY (FINAL): GREEN OWNER COPY (FINAL): YELLOW INSPECTION COPY (INITIAL): PINK OWNER COPY (INITIAL): GOLD