IREDELL COUNTY HEALTH DEPARTMENT

STATESVILLE 704-878-5305 MOORESVILLE 704-664-5281

IMPROVEMENT PERMIT / AUTHORIZATION TO CONSTRUCT / OPERATION PERMIT / EXISTING SYSTEM INSPECTION

PERMIT# 093695 PIN# 4659711201 / 3382 / 4659815233 DATE 1-10-2001

OWNER OR CONTRACTOR Pink Ney Overcash / Vincent Fe[illegible] Business 902-4053 Home

ADDRESS 2020 Crowch Circle, Statesville NC 28625

LOCATION 413 Shepherd Rd. Hwy 21/115 North R Shepherd Rd. 1st house on right

SUBDIVISION BLOCK / SECTION LOT LOT AREA SITE CLASS. DESIGN FLOW 360gpd L.T.A.R.

Septic Tank: Existing Gallons; STB Date

Pump Tank: Gallons; PT Date

Pump Make: Model Serial No.

Nitrification Field: No Fields Square Feet Linear Feet

No Lines Trench Width Exist Max Trench Bottom Depth Gravel Depth

☒ New System ☐ Repair System Type: I, II, III, IV, V, VI

System Description: Gravity-Conventional Bed.

Repair System Description:

Maintenance Agreement Required: ☐ Yes ☒ No

☒ House/Mod. Home No. Bedrooms 3

☐ Mobile Home No. Bathrooms 2

☐ Business No. Employees

☐ Other


☐ Slab ☒ Crawl Space ☐ Basement w/plumbing ☐ Basement wo/plumbing

Water Supply: ☒ Individual ☐ Public ☐ Community

Comments:/Conditions: Existing Septic System appears to be functioning okay at time of INSPECTION, No problems Noticed

Comments:/Conditions: Approved for 3 Bedroom / 2 Baths.

INITIAL SITE SKETCH ☒ Not to Scale

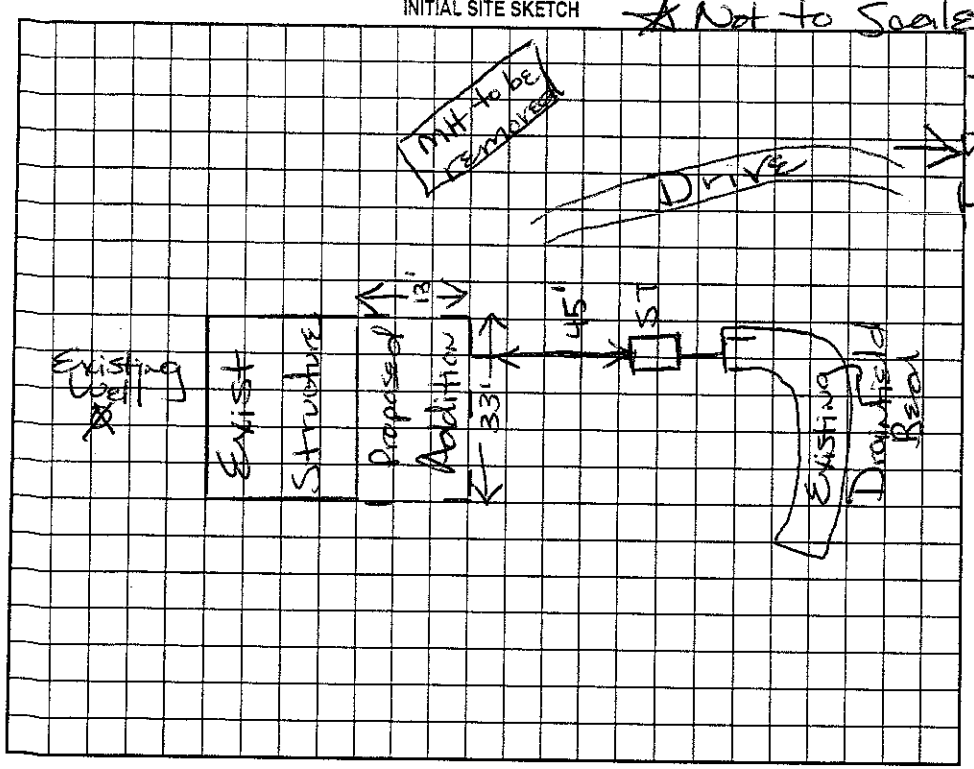

AS BUILT SKETCH

Permit can be suspended or revoked if any false information is supplied toward securing the permit/any unauthorized changes are made to the site/any unauthorized changes are made in the installation of the system. Improvement Permit with plat valid without expiration. Improvement Permit with site plan valid for sixty months. Authorization to Construct is valid for a period equal to that of Improvement Permit – not to exceed sixty months.

Signed: Vincent R. Fe[illegible] date 1-10-2001

Improvement Permit by: Maria H. Dotson RS. date 1/10/2001

Authorization to Construct by: date

Installed by:

Operation Permit by: date

Existing System Inspection by: Maria H. Dotson RS. date 1/10/2001

HEALTH DEPT. COPY: WHITE OWNER COPY (FINAL): YELLOW OWNER COPY (INITIAL): PINK