IREDELL COUNTY HEALTH DEPARTMENT

STATESVILLE 704-878-5305 ☑ MOORESVILLE 704-664-5281

IMPROVEMENT PERMIT / AUTHORIZATION TO CONSTRUCT / OPERATION PERMIT / EXISTING SYSTEM INSPECTION

PERMIT # 174195 PIN # 4628-42-0235 DATE 8-28-12

OWNER or APPLICANT INGLE BUILDERS INC. PHONE: Business 704-634-0849 Home:

OWNER or APPLICANT ADDRESS 510 CAMP CREEK RD. IRON STATION, NC 28080

LOCATION / DIRECTIONS 150W, TR PINNACLE LN, C END

SUBDIVISION PINNACLE SHORES BLOCK / SECTION 3 LOT # 39 LOT AREA .96 AC DESIGN FLOW 360 L.T.A.R. .3

Septic Tank 1000 Gallons: STB Date

Pump Tank 1000 Gallons: P T Date

Pump Make Model Serial #

Nitrification Field No Fields 1 No Lines 3 Linear Feet 300'

Trench Width 24" 36" Max. Trench Bottom Depth 36" Gravel Depth — ☐ GRAVITY ☒ PRESSURE

☒ New System ☐ Repair ☐ Expansion System ☐ I ☐ II ☐ III ☐ IV ☐ V ☐ VI

System Description: PM-1 PANEL BLACK B

Repair System Description: LP- PANEL

Maintenance Agreement Required ☐ YES ☒ NO


☒ Residence No. Bedrooms 3 ☐ Business No. Persons ☐ Other No. Employees ☐ Slab ☐ Crawl Space ☒ Basement w/plumbing ☐ Basement w/o plumbing

Water Supply ☐ Private ☐ Public ☒ Community


Comments / Conditions

Comments / Conditions

INITIAL SITE SKETCH

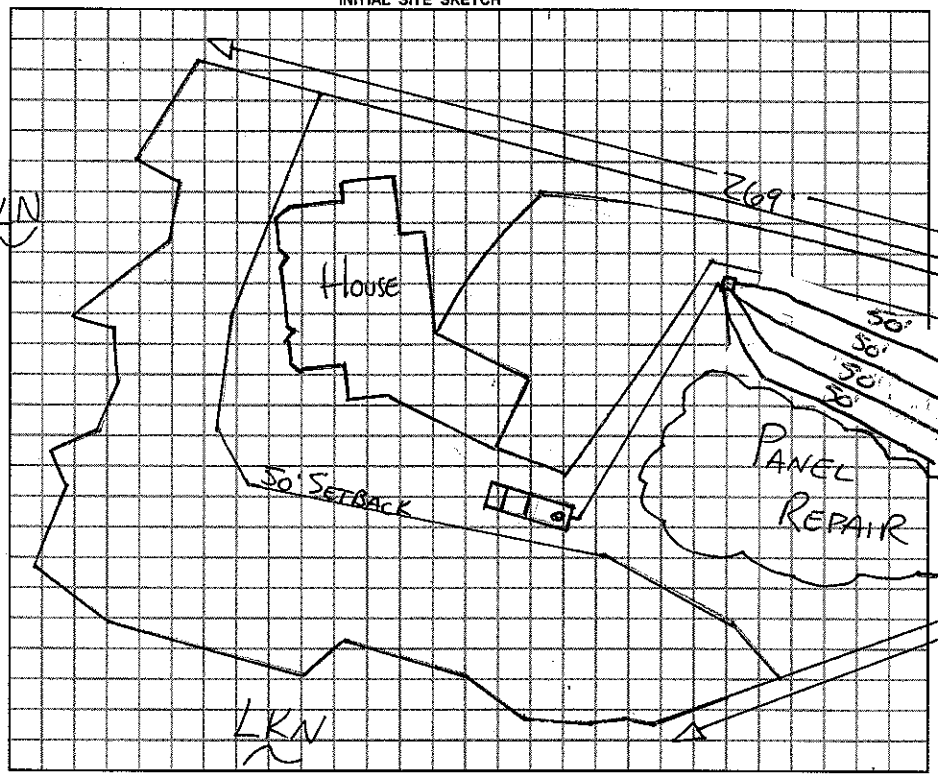

AS BUILT SKETCH

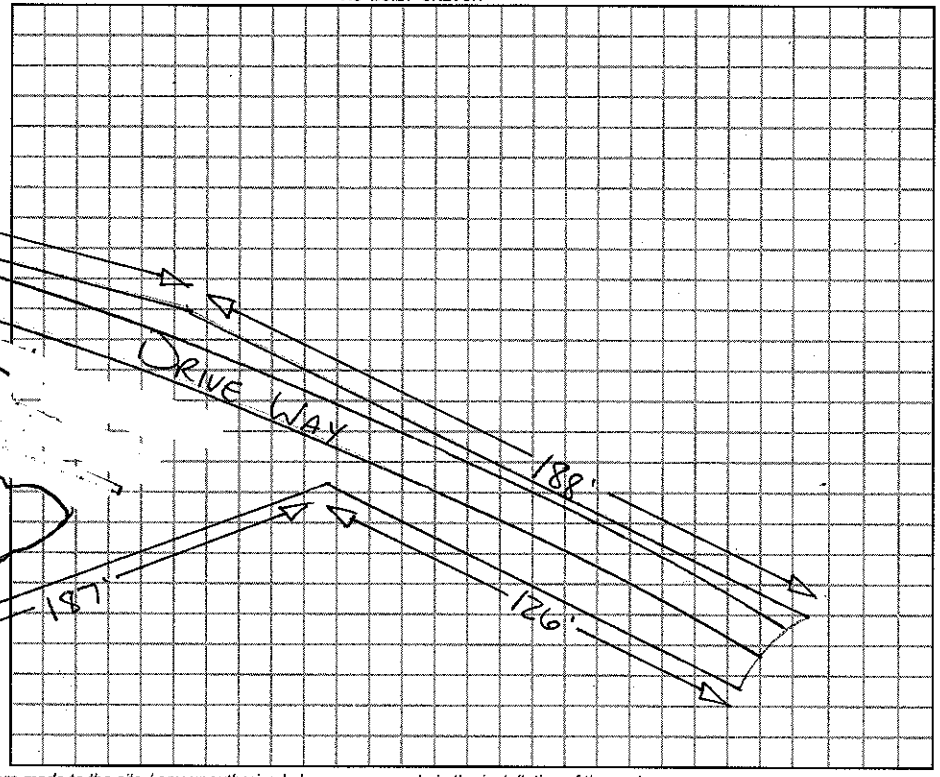

Permit can be suspended or revoked if any false information is supplied toward securing the permit / any unauthorized changes are made to the site / any unauthorized changes are made in the installation of the system.

☐ *IMPROVEMENT PERMIT w/ plat valid without expiration.* ☒ *IMPROVEMENT PERMIT w / site plan valid for 60 mos.* ☒ *AUTHORIZATION TO CONSTRUCT valid for period equal to IMPROVEMENT PERMIT-not to exceed 60 mo.*

Owner / Applicant Signature: Mark Ingle Date 9-4-12

Improvement Permit by: RALPH Date

Authorization to Construct by: RALPH Date

Installed by:

Operation Permit by: Date:

Existing System Inspected by: Date:

YOU SHOULD CONTACT A LOCATOR SERVICE PRIOR TO ANY EXCAVATION.

WHITE COPY Environmental Health YELLOW COPY (Final) Owner / Applicant PINK COPY (Initial) Owner / Applicant