IREDELL COUNTY HEALTH DEPARTMENT

Statesville Office (704) 878-5305 Mooresville Office (704) 660-3625

IMPROVEMENT PERMIT / AUTHORIZATION TO CONSTRUCT / OPERATION PERMIT / EXISTING SYSTEM

PERMIT # 209547

PIN # 4659883098

APPLICANT: Paul McClain

APPLICANT ADDRESS: 475 Shepherd Rd.

SITE ADDRESS: 455 Shepherd Rd.

PHONE: 704-634-5812 ALT. PHONE: N/A

SITE DIRECTIONS: Hwy 115N TR Shepherd Rd. Property on Left

SUBDIVISION: N/A

SECTION: N/A LOT # N/A LOT AREA: 0.93 acres DESIGN FLOW: 360gpd L.T.A.R.: Existing

Septic Tank 1000 (gal) STB Date

Pump Tank (gal) PT Date

Pump Make Model Serial #

Nitrification Fields Ex # Lines Ex Linear Ft: Ex

Trench Width Ex Max. Trench Bottom Depth Ex Gravel Depth Ex

☐ New System ☑ Repair ☐ Expansion System Type: I (II) III IV V VI

System Description:

Repair System Description: TANK

Maintenance Agreement Required: ☐ YES ☑ NO

☐ GRAVITY ☐ PRESSURE

☑ Residence ☐ Business ☐ Other ☐ Slab ☐ Basement w/plumbing


No. Bedrooms 3 No. Persons 6 No. Employees

☑ Crawl Space ☐ Basement w/o plumbing


Water Supply: ☑ Private ☐ Public ☐ Community

Comments / Conditions: Pump & crush existing septic tank. Set new septic tank @ location shown below & connect to existing drainfield.

INITIAL SITE SKETCH

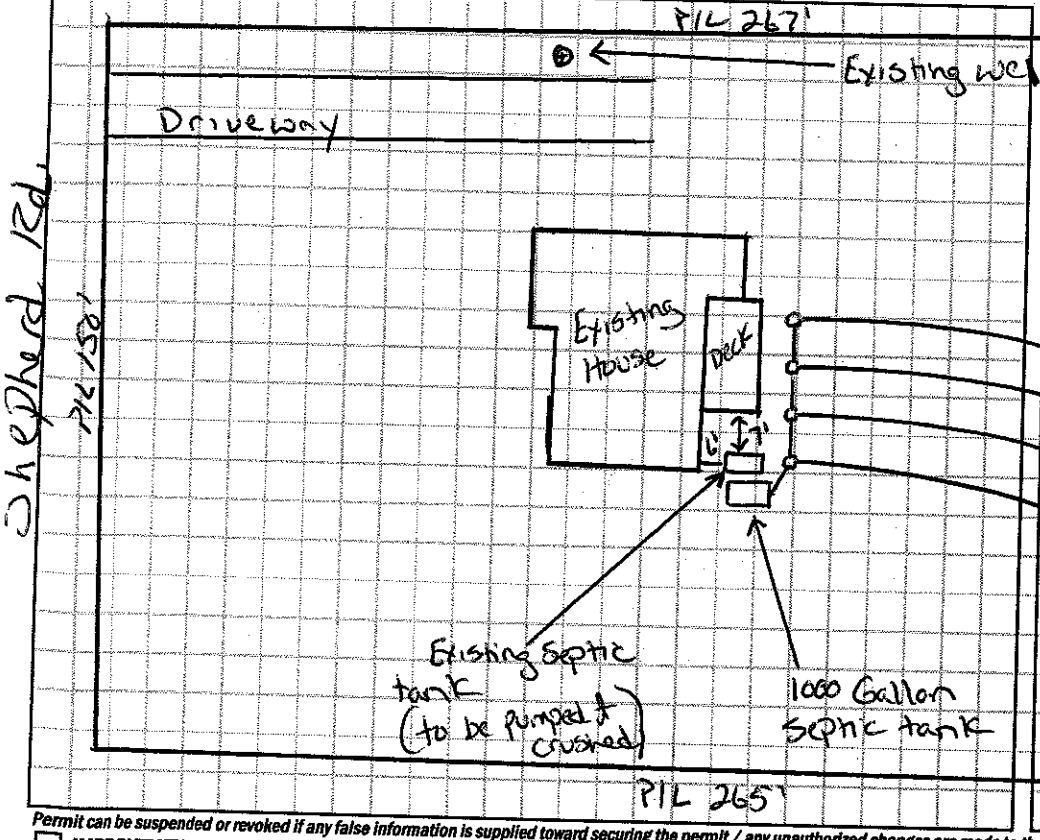

AS BUILT SKETCH

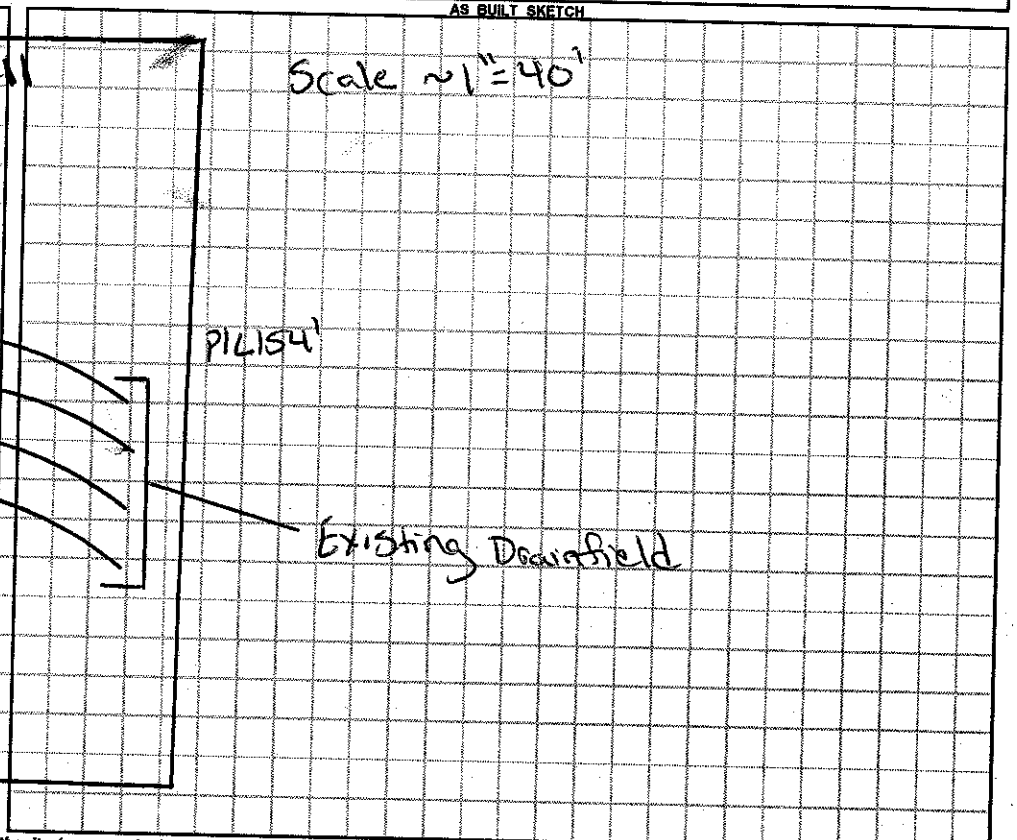

Permit can be suspended or revoked if any false information is supplied toward securing the permit / any unauthorized changes are made to the site / any unauthorized changes are made in the installation of the system. CONTACT A LOCATOR SERVICE PRIOR TO ANY EXCAVATION

☐ IMPROVEMENT PERMIT *with plat* valid without expiration. ☑ IMPROVEMENT PERMIT *with site plan* valid for 60 mos. ☑ AUTHORIZATION TO CONSTRUCT valid for period equal to IMPROVEMENT PERMIT--not to exceed 60 mo.

Owner / Applicant Signature: Paul K McCla

IMPROVEMENT PERMIT by: Justin Henderson Date: 4-10-15

AUTHORIZATION TO CONSTRUCT by: Justin Henderson Date: 4-9-15

Installed by: K ORBISON

OPERATION PERMIT by: Date: 4-9-15

APPROVED APR 21 2015

Existing System Inspected by: Date:

Health Dept. Copy - WHITE Applicant (Final Approval) - YELLOW Applicant (Conditional Approval) - PINK