IREDELL COUNTY HEALTH DEPARTMENT

STATESVILLE 704-878-5305 MOORESVILLE 704-664-5281

IMPROVEMENT PERMIT / AUTHORIZATION TO CONSTRUCT / OPERATION PERMIT / EXISTING SYSTEM INSPECTION

PERMIT # REPAIR PIN # 4659-89-3504 DATE 7-30-09

OWNER or APPLICANT RACHEL + GREG HARLING PHONE: Business 704-500-2525 Home:

OWNER or APPLICANT ADDRESS 523 SHEPHERD RD TROUTMAN NC

LOCATION / DIRECTIONS 523 SHEPHERD RD

SUBDIVISION — BLOCK / SECTION — LOT # — LOT AREA .6AC DESIGN FLOW 360 L.T.A.R. .3

Septic Tank 1000 Gallons: STB 760 Date 5/5/09

Pump Tank — Gallons: PT — Date —

Pump Make — Model — Serial # —

Nitrification Field No Fields — No Lines — Linear Feet —

Trench Width — Max. Trench Bottom Depth EXISTING Gravel Depth —

☐ New System ☒ Repair ☐ Expansion System Type I II III IV V VI

System Description: 0

Repair System Description: NEW 1000 GAL TANK

Maintenance Agreement Required ☐ YES ☒ NO

☐ GRAVITY ☐ PRESSURE


☒ Residence No. Bedrooms 3 ☐ Business No. Persons — ☐ Other No. Employees — ☐ Slab ☒ Crawl Space ☐ Basement w/plumbing ☐ Basement w/o plumbing

Water Supply: ☒ Private ☐ Public ☐ Community


Comments / Conditions 1) PUMP, CRUSH + FILL OLD TANK 2) ADD NEW 1000 GAL TANK WITH BAFFLE WALL + FILTER + HOOK TO EXISTING DRAIN FIELD

Comments / Conditions

INITIAL SITE SKETCH

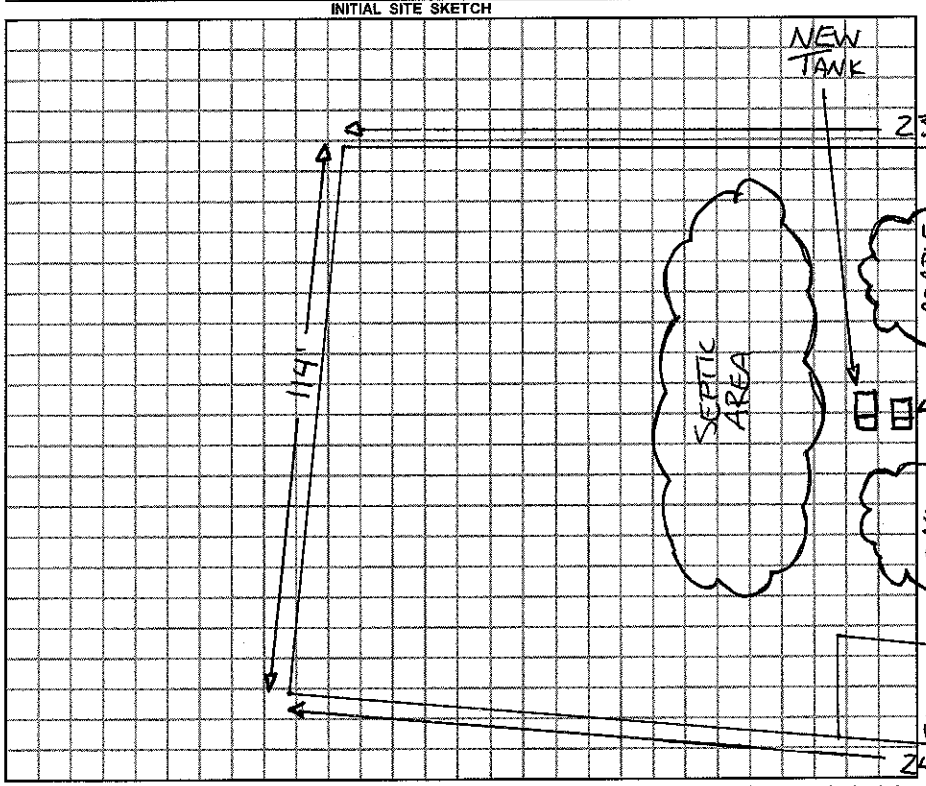

AS BUILT SKETCH

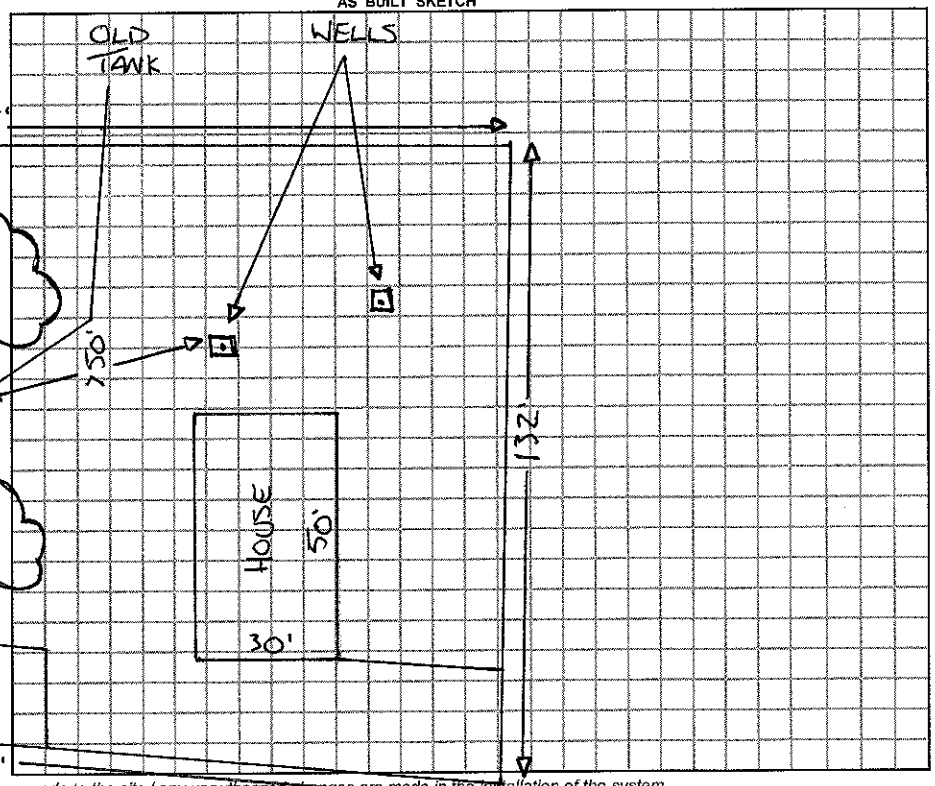

Permit can be suspended or revoked if any false information is supplied toward securing the permit / any unauthorized changes are made to the site / any unauthorized changes are made in the installation of the system.

☐ *IMPROVEMENT PERMIT w / plat valid without expiration.* ☐ *IMPROVEMENT PERMIT w / site plan valid for 60 mos.* ☒ *AUTHORIZATION TO CONSTRUCT valid for period equal to IMPROVEMENT PERMIT-not to exceed 60 mo.*

Owner / Applicant Signature: — Date —

Improvement Permit by: JR-A RS Date 7-30-09

Authorzation to Construct by: JR-A RS Date 7-30-09

Installed by: —

Operation Permit by: Wesley Sparks RS Date: 9/1/09

Existing System Inspected by: — Date: —

YOU SHOULD CONTACT A LOCATOR SERVICE PRIOR TO ANY EXCAVATION.

WHITE COPY Environmental Health YELLOW COPY (Final) Owner / Applicant PINK COPY (Initial) Owner / Applicant