IREDELL COUNTY HEALTH DEPARTMENT - *ENVIRONMENTAL HEALTH* ☐ STATESVILLE OFFICE 704-878-5305 ☒ MOORESVILLE OFFICE 704-664-5281

IMPROVEMENT PERMIT / AUTHORIZATION TO CONSTRUCT / OPERATION PERMIT / EXISTING SYSTEM INSPECTION

2100

PERMIT # 108140 PIN # 4659-89-3885 DATE 8-31-11

OWNER TERESA NEWTON APPLICANT: FREEDOM HOMES PHONE: Home/Cell # 704-528-7960 Business #

SITE ADDRESS 537 SHEPHERD RD OWNER / APPLICANT ADDRESS 1042 CH. HWY

SITE DIRECTIONS 21 N. SHEPHERD RD

SUBDIVISION BLOCK / SECTION LOT # 4 LOT AREA .56 AC DESIGN FLOW 360 L.T.A.R. .3

Septic Tank 1000 Gallons: STB 760 Date 4-18 ☒ New System ☐ Repair ☐ Expansion System Type I II (III) IV V VI ☒ Residence No. Bedrooms 3 Water Supply ☒ Private

Pump Tank Gallons: P T Date System Description: 25% REDUCTION ☐ Business No. Persons ☐ Public


Pump Make Model Serial # Repair System Description: SAME ☐ Other No. Employees ☐ Community

No. Nitrification Fields: 1 No. Lines 4 Linear Feet 300' Maintenance Agreement Required ☐ YES ☒ NO ☐ Slab ☒ Crawl Space

Trench Width 36" Max. Trench Bottom Depth 36" Gravel Depth ☒ GRAVITY ☐ PRESSURE ☐ Basement w/plumbing ☐ Basement w/o plumbing

Comments / Conditions ① MEET ALL SETBACKS ② MAY USE ENDMAP DISTRIBUTION IF CHAMBERS ARE USED.

INITIAL SITE SKETCH

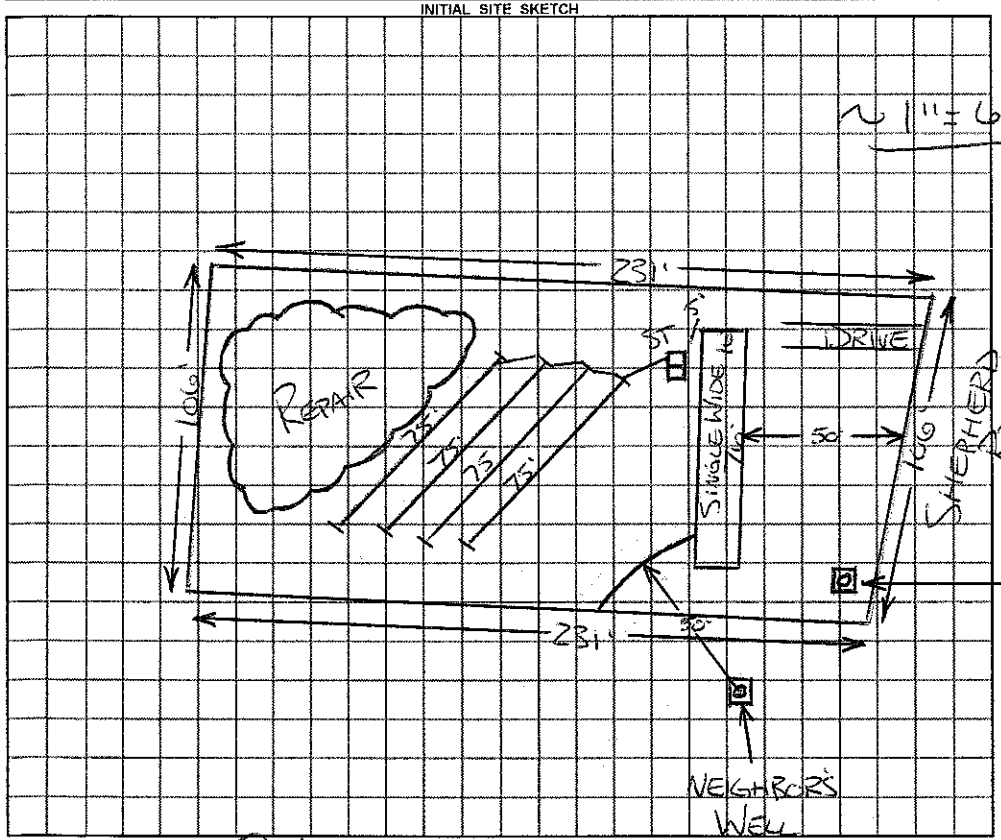

AS BUILT SKETCH

15 CHAMBERS PERLINE (ARC 36 5 CH)

INSTALLED AS DRAWN

Permit can be suspended or revoked if any false information is supplied toward securing the permit / any unauthorized changes are made to the site / any unauthorized changes are made in the installation of the system.

☐ ***IMPROVEMENT PERMIT*** with plat valid without expiration. ☐ ***IMPROVEMENT PERMIT*** with plat valid without expiration. site plan valid 60 mo. ☒ ***AUTHORIZATION TO CONSTRUCT*** valid for period equal to IMPROVEMENT PERMIT--not to exceed 60 mo.

Owner / Applicant Signature: Teresa Newton Date 9-27-11 Installed by: ABES IS GRADING

IMPROVEMENT PERMIT by: REHS Date 8-31-11 OPERATION PERMIT by: REHS Date 9-28-11

AUTHORIZATION TO CONSTRUCT by: 8-31-11 Existing System Inspected by: REHS Date

YOU SHOULD CONTACT A LOCATOR SERVICE BEFORE YOU DIG ... TION

White Copy – Environmental Health YELLOW COPY (Final) Owner / Applicant PINK COPY (Initial) Owner / Applicant