12100

IREDELL COUNTY HEALTH DEPARTMENT

STATESVILLE 704-878-5305 MOORESVILLE 704-664-5281

IMPROVEMENT PERMIT / AUTHORIZATION TO CONSTRUCT / OPERATION PERMIT / EXISTING SYSTEM INSPECTION

PERMIT# 104438 PIN# 4659-92-5352.68 4659-91-0756 DATE July 9, 02

OWNER OR CONTRACTOR KFS Investments - ES Johnson Bldrs. LLC PHONE: Business 704-799-2996 Home

ADDRESS 149 Yacht Cove Ln Mooresville 28117

LOCATION Lk-21N TR Shinnville Rd. TL Brooklea Dr. on left

SUBDIVISION Brooklea BLOCK / SECTION 2 LOT 68 LOT AREA .77Ac SITE CLASS PS DESIGN FLOW 360gpd L.T.A.R. .3 System Area only

Septic Tank: 1000 Gallons; STB 312 Date 3-14-03

Pump Tank: 1000 Gallons; PT 27 Date 9-23-03

Pump Make: Zoeller Model 153 Serial No.

Nitrification Field: No Fields 1 Square Feet 900 Linear Feet 300

No Lines 4 Trench Width 36" Max Trench Bottom Depth 36" Gravel Depth N/A

☑ New System ☐ Repair System Type: I, II, III, IV, V, VI

System Description: PM 25% Reduction

Repair System Description: LP PPBPS

Maintenance Agreement Required: ☐ Yes ☑ No Virtually

☑ House/Mod. Home ☐ Mobile Home ☐ Business ☐ Other


No. Bedrooms 3 No. Bathrooms 2 No. Employees

☐ Slab ☑ Crawl Space ☐ Basement w/plumbing ☐ Basement wo/plumbing

Water Supply: ☑ Individual ☐ Public ☐ Community

Comments:/Conditions: 230'


INITIAL SITE SKETCH

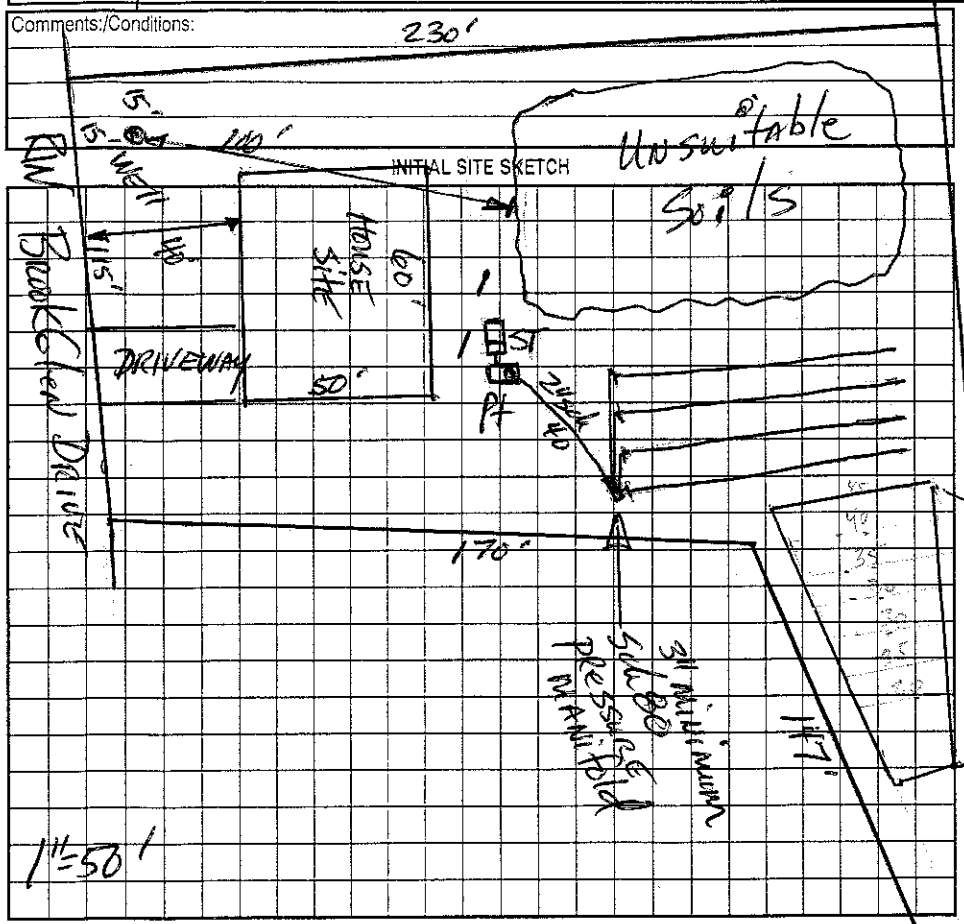

Comments:/Conditions: Remove any old burns/terraces in septic system area.

Checked tanks, lines & pressure 10/31/03

AS BUILT SKETCH

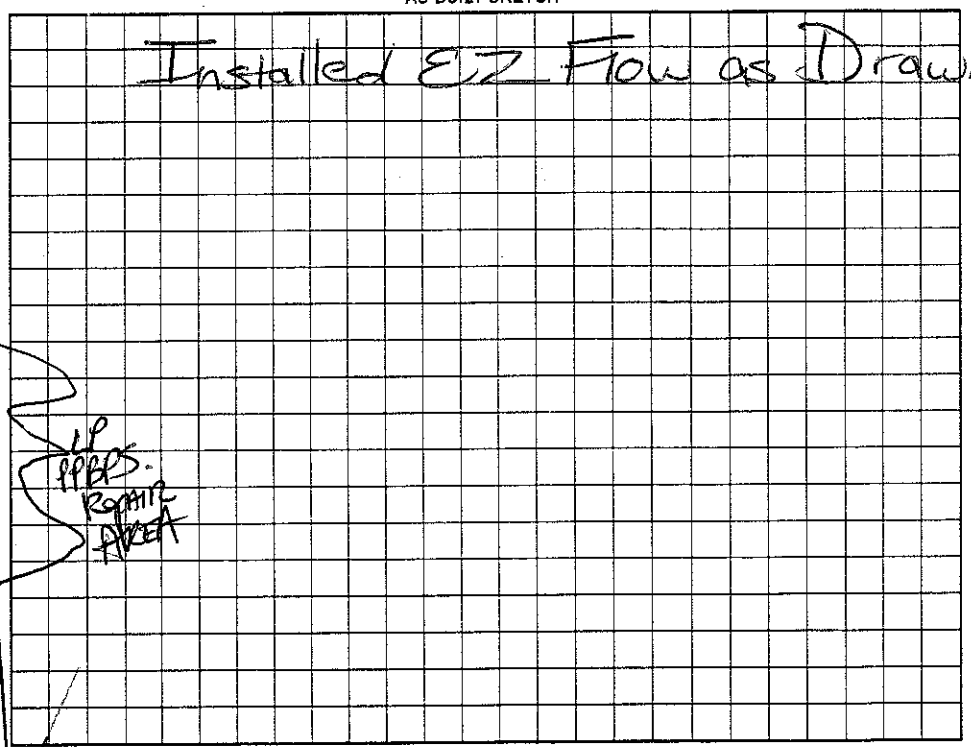

Permit can be suspended or revoked if any false information is supplied toward securing the permit/any unauthorized changes are made to the site/any unauthorized changes are made in the installation of the system. Improvement Permit with plat valid without expiration. Improvement Permit with site plan valid for sixty months. Authorization to Construct is valid for a period equal to that of Improvement Permit – not to exceed sixty months.

Signed: date 8-9-02 Installed by: Willie Christenbary

Improvement Permit by: Mark Atkinson RS date 7-9-02 Operation Permit by: Wesley Sparks RS date 12/8/03

Authorization to Construct by: Maria H. Dotson RS date 3-27-03 Existing System Inspection by: date

HEALTH DEPT. COPY: WHITE OWNER COPY (FINAL): YELLOW OWNER COPY (INITIAL): PINK