11:30

# IREDELL COUNTY HEALTH DEPARTMENT

ST..LLE 704-878-5305 MOORESVILLE 704-664-5281

## IMPROVEMENT PERMIT / AUTHORIZATION TO CONSTRUCT / OPERATION PERMIT / EXISTING SYSTEM INSPECTION

PERMIT# 104434 PIN# ~~4659-92-5352.65~~ 4659-91-2474 DATE July 8, 02

OWNER OR CONTRACTOR KFS Investments / ES Johnson Build. PHONE: Business Home

ADDRESS 149 Yacht Cove Ln. Mooresville 28117

LOCATION 115-21N. TR Shannville Rd TL Brookglen on left

SUBDIVISION Brookglen BLOCK / SECTION 2 LOT 65 LOT AREA .83Ac SITE CLASS PS DESIGN FLOW 360gpd L.T.A.R. .23

Septic Tank: 1000 Gallons; STB 1012 Date 9-23-02
Pump Tank: Gallons; PT Date
Pump Make: Model Serial No.
Nitrification Field: No Fields 1 Square Feet 1200 Linear Feet 400
No Lines 3 ~~approx~~ Trench Width 36" Max Trench Bottom Depth 36" Gravel Depth 12"

☑ New System ☐ Repair System Type: I, II, III, IV, V, VI
System Description: Gravity Conventional
Repair System Description: Same
Maintenance Agreement Required: ☐ Yes ☑ No

☑ House/Mod. Home No. Bedrooms 3
☐ Mobile Home No. Bathrooms 2
☐ Business No. Employees
☐ Other
☐ Slab ☑ Crawl Space ☐ Basement w/plumbing ☐ Basement wo/plumbing


Water Supply: ☑ Individual ☐ Public ☐ Community

Comments/Conditions: Remove any old barns/terraces in septic system area.

Comments/Conditions: Yellow filter & tank marker installed

1"=50'

INITIAL SITE SKETCH

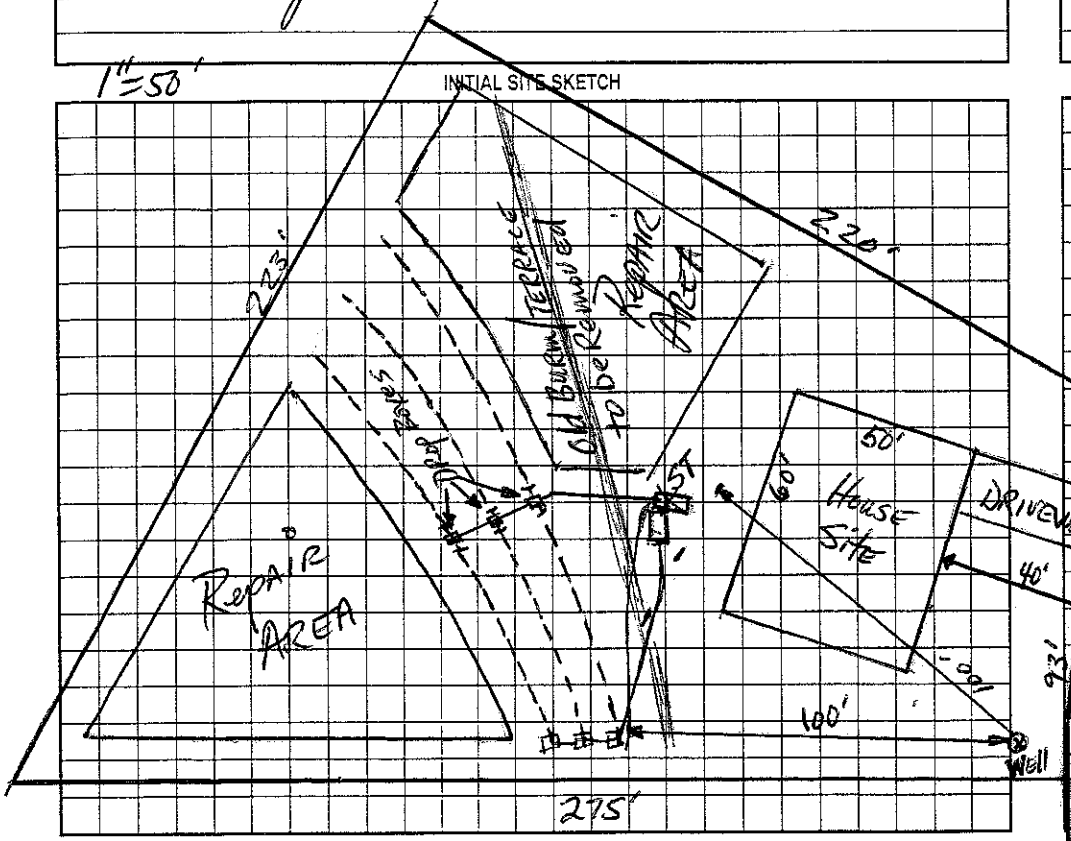


AS BUILT SKETCH

Installed in 3-100' lines end fed.

~105' btw Drainfield & well

Permit can be suspended or revoked if any false information is supplied toward securing the permit/any unauthorized changes are made to the site/any unauthorized changes are made in the installation of the system. Improvement Permit with plat valid without expiration. Improvement Permit with site plan valid for sixty months. Authorization to Construct is valid for a period equal to that of Improvement Permit – not to exceed sixty months.

Signed: date 8-5-02

Improvement Permit by: RS date 7-8-02

Authorization to Construct by: RS date 12/23/02

Installed by: Tommy Frye RS

Operation Permit by: Mark Dalton date 5/13/03

Existing System Inspection by: date

HEALTH DEPT. COPY: WHITE OWNER COPY (FINAL): YELLOW OWNER COPY (INITIAL): PINK