IREDELL COUNTY HEALTH DEPARTMENT

STATESVILLE 704-878-5305 MOORESVILLE 704-664-5281

IMPROVEMENT PERMIT / AUTHORIZATION TO CONSTRUCT / OPERATION PERMIT / EXISTING SYSTEM INSPECTIO

PERMIT# 104435 PIN# ~~4659-92-5352.66~~ 4659-91-2506 DATE July 8, 02

OWNER OR CONTRACTOR KFS Investments PHONE: Business _____ Home _____

ADDRESS 149 Yacht Cove Ln. Mooresville 28117

LOCATION 115-21N TR Shinnville Rd. TL Brookglen Dr 255 Brookglen on left

SUBDIVISION Brookglen BLOCK / SECTION 2 LOT 66 LOT AREA .63 Ac SITE CLASS. B5 DESIGN FLOW 360gpd L.T.A.R. .3

Septic Tank: 1000 Gallons; STB 794 Date 3/03/03

Pump Tank: _____ Gallons; PT _____ Date _____

Pump Make: _____ Model _____ Serial No. _____

Nitrification Field: No Fields 1 Square Feet 900 Linear Feet 300

No Lines 3 @100' Trench Width 36" Trench Bottom Depth 36" Gravel Depth _____

☑ New System ☐ Repair System Type: I, II, III, IV, V, VI

System Description: Gravity 25% Reduction

Repair System Description: Same

Maintenance Agreement Required: ☐ Yes ☑ No

☑ House/Mod. Home No. Bedrooms 3

☐ Mobile Home No. Bathrooms 2

☐ Business No. Employees _____

☐ Other _____

☐ Slab ☑ Crawl Space ☐ Basement w/plumbing ☐ Basement wo/plumbing


Water Supply: ☑ Individual ☐ Public ☐ Community

Comments:/Conditions: Install Laterals at 36" Trench bottom depth. Remove any old burns/terraces in septic system area.

Comments:/Conditions: Reviewed Building plans, essentially in Compliance with I.P. Driveway on left instead of right. OK MB

1"=50'

INITIAL SITE SKETCH

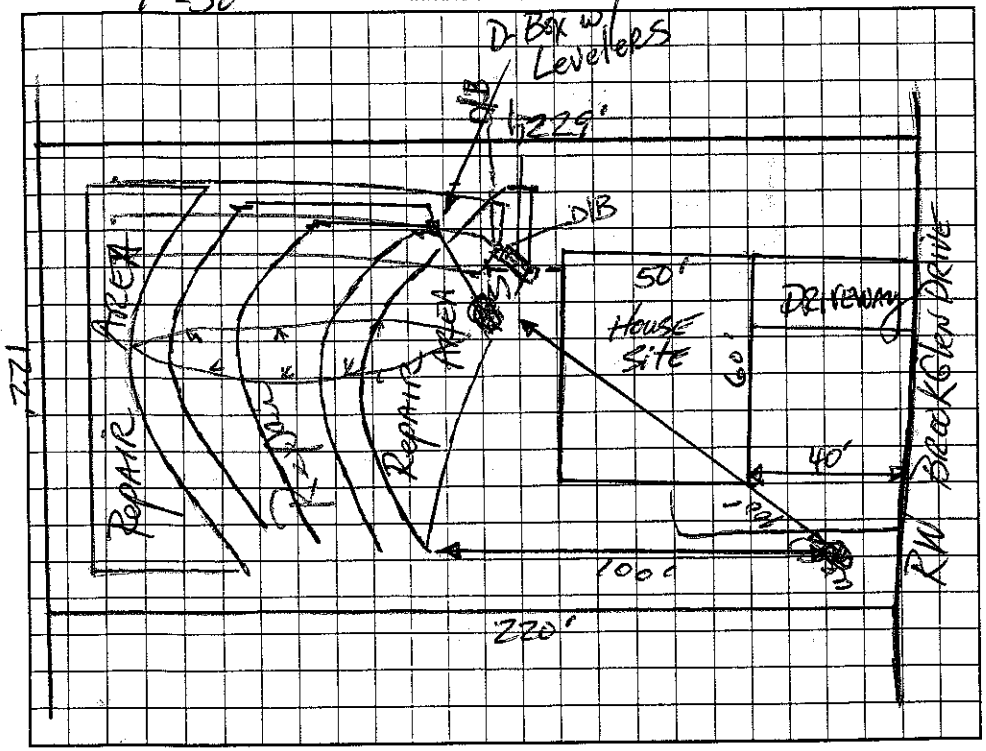

AS BUILT SKETCH

6/26/03 EZ FLOW INSTALLED

Permit can be suspended or revoked if any false information is supplied toward securing the permit/any unauthorized changes are made to the site/any unauthorized changes are made in the installation of the system. Improvement Permit with plat valid without expiration. Improvement Permit with site plan valid for sixty months. Authorization to Construct is valid for a period equal to that of Improvement Permit – not to exceed sixty months.

Signed: _____ date 8 9 02 Installed by: Willie Christenbury

Improvement Permit by: _____ date 7-8-02 Operation Permit by: Wesley Sparks R.S. date 6/26/03

Authorization to Construct by: _____ date 2/10/03 Existing System Inspection by: _____ date _____

HEALTH DEPT. COPY: WHITE OWNER COPY (FINAL): YELLOW OWNER COPY (INITIAL): PINK