IREDELL COUNTY HEALTH DEPARTMENT

STATESVILLE 704-878-5305 MOORESVILLE 704-664-5281

IMPROVEMENT PERMIT / AUTHORIZATION TO CONSTRUCT / OPERATION PERMIT / EXISTING SYSTEM INSPECTION

PERMIT# 104629 PIN# ~~4659-92-5352.98~~ 4659913787 DATE July 22, 02

OWNER OR CONTRACTOR KFS Investments / Calkins Construction PHONE: Business _____ Home _____

ADDRESS 149 Yacht Cove Dr. Mooresville 28117

LOCATION 115-21 N TR Shinnville Rd. TL Brookglen Dr. cross creek Bear left on Right

SUBDIVISION Brookglen BLOCK / SECTION 2 LOT 98 LOT AREA .58Ac SITE CLASS. FS DESIGN FLOW 360gpd L.T.A.R. .3 SYSTEM AREA (front)

Septic Tank: 1000 Gallons; STB 312 Date 2 28 05
Pump Tank: 1000 Gallons; PT 283 Date 2-28-05
Pump Make: _____ Model _____ Serial No. _____
Nitrification Field: No Fields 1 Square Feet 900 Linear Feet 300
No Lines 3 Trench Width 36" Max Trench Bottom Depth 36

☑ New System ☐ Repair System Type: I II III IV V VI
System Description: PM - 25% Reduction
Repair System Description: LPPPBPS
Maintenance Agreement Required: ☐ Yes ☑ No
Gravel Depth N/A ☐ Slab ☑ Crawl Space ☐ Basement w/plumbing ☐ Basement wo/plumbing

☑ House/Mod. Home No. Bedrooms 3
☐ Mobile Home No. Bathrooms 2
☐ Business No. Employees _____
☐ Other _____


Water Supply: ☑ Individual off Site ☐ Public ☐ Community

Comments: Conditions: Well for Lot 98 located in well easement on Lot 99 - Keep 100' separation Remove any old burns / terraces in septic system area.

Comments: Conditions: Tanks Checked 4/21/05 Lines Checked 4/25/05 MD Reviewed Building Plans essentially in compliance with Original permit


The proposed / existing Pool addition does not appear to impact the existing septic system.
**NOTE: MIN 15' from SEPTIC
REHS _____
Date: 5-23-1P
ICHD-Environmental Health Division

1"=5

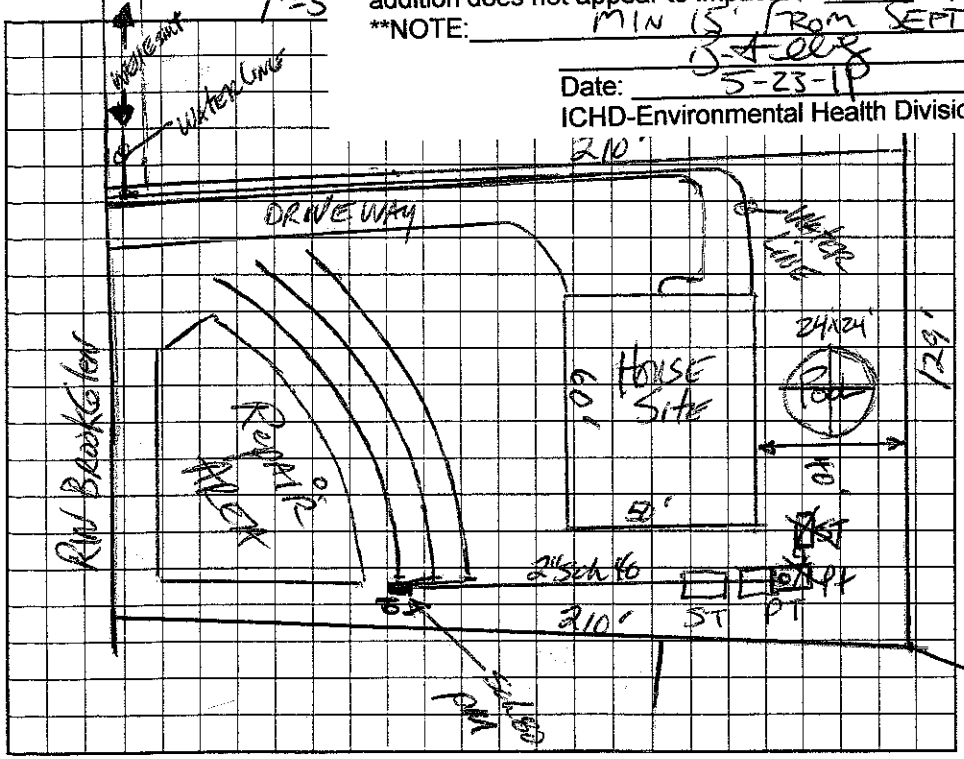

AS BUILT SKETCH

te: Gas line into Drainfield area ~10'
nstalled 4 lines @ 75' ea.
EZ Flow

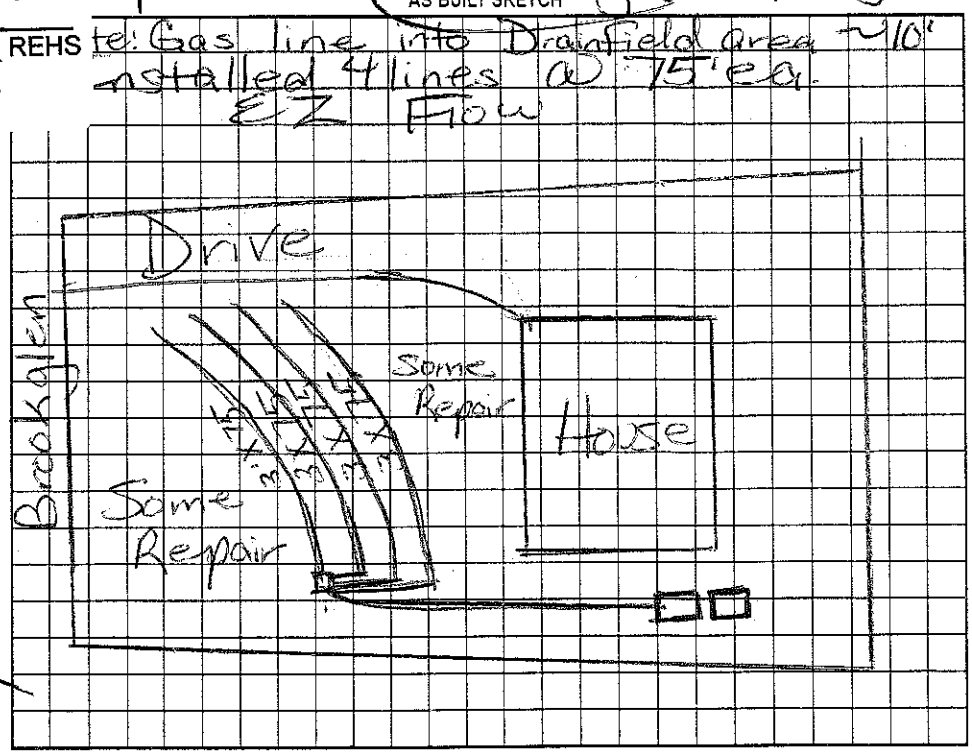

Permit can be suspended or revoked if any false information is supplied toward securing the permit/any unauthorized changes are made to the site/any unauthorized changes are made in the installation of the system. Improvement Permit with plat valid without expiration. Improvement Permit with site plan valid for sixty months. Authorization to Construct is valid for a period equal to that of Improvement Permit – not to exceed sixty months.

Signed: _____ date 8-9-02 Installed by: Willie Christenbury

Improvement Permit by: _____ RS date 7-22-02 Operation Permit by: Maria H. Dotson RS date 5/12/05

Authorization to Construct by: Maria H. Dotson RS date 12/9/04 Existing System Inspection by: _____ date _____

HEALTH DEPT. COPY: WHITE OWNER COPY (FINAL): YELLOW OWNER COPY (INITIAL): PINK