IREDELL COUNTY HEALTH DEPARTMENT

STATESVILLE 704-878-5305 MOORESVILLE 704-664-5281

IMPROVEMENT PERMIT / AUTHORIZATION TO CONSTRUCT / OPERATION PERMIT / EXISTING SYSTEM INSPECTION

PERMIT# 104657 PIN# 4659-92-5352.119 4659-91-5970 DATE July 31, 02

OWNER OR CONTRACTOR KFS Investments / ES Johnson Build. PHONE: Business 704-799-2976 Home

ADDRESS 149 Yacht Cove Ln. Mooresville 28117

LOCATION 115-21 N. TR Shinnville Rd. TR Brookglen Dr. cross creek Bear Right TR Middlegreen Ct. at end

SUBDIVISION Brookglen BLOCK / SECTION 2 LOT 119 LOT AREA .89Ac SITE CLASS PS DESIGN FLOW 360gpd L.T.A.R. .25-.3 @ 36"46

Septic Tank: 1000 Gallons; STB 794 Date 3-21-03

Pump Tank: 1000 Gallons; PT 27 Date 8-15-03

Pump Make: Model Serial No.

Nitrification Field: No Fields 1 Square Feet 960 Linear Feet 320

No Lines 4@80' Trench Width 36" Trench Bottom Depth 36" Gravel Depth 11"

☑ New System ☐ Repair System Type: I, II, III, IV, V, VI

System Description: Rm - 25% Reduction

Repair System Description: LPPBPS

Maintenance Agreement Required: ☐ Yes ☑ No

☑ House/Mod. Home No. Bedrooms 3

☐ Mobile Home No. Bathrooms 2

☐ Business No. Employees

☐ Other

☐ Slab ☑ Crawl Space ☐ Basement w/plumbing ☐ Basement wo/plumbing

Water Supply: ☑ Individual ☐ Public ☐ Community


Comments/Conditions: Remove any old burna stoneaces in septic system area. Install laterals at 36" trench bottom depth.

Comments/Conditions: Check for Filter


Tanks checked 9/17/03

1" = 50'

INITIAL SITE SKETCH

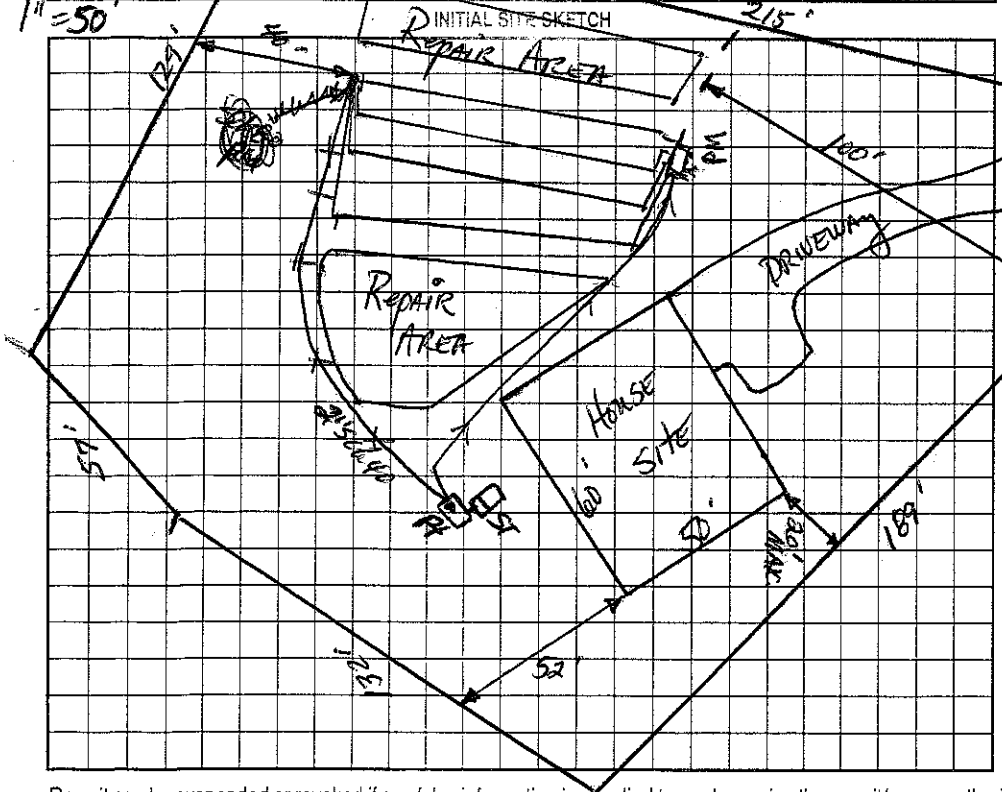

AS BUILT SKETCH

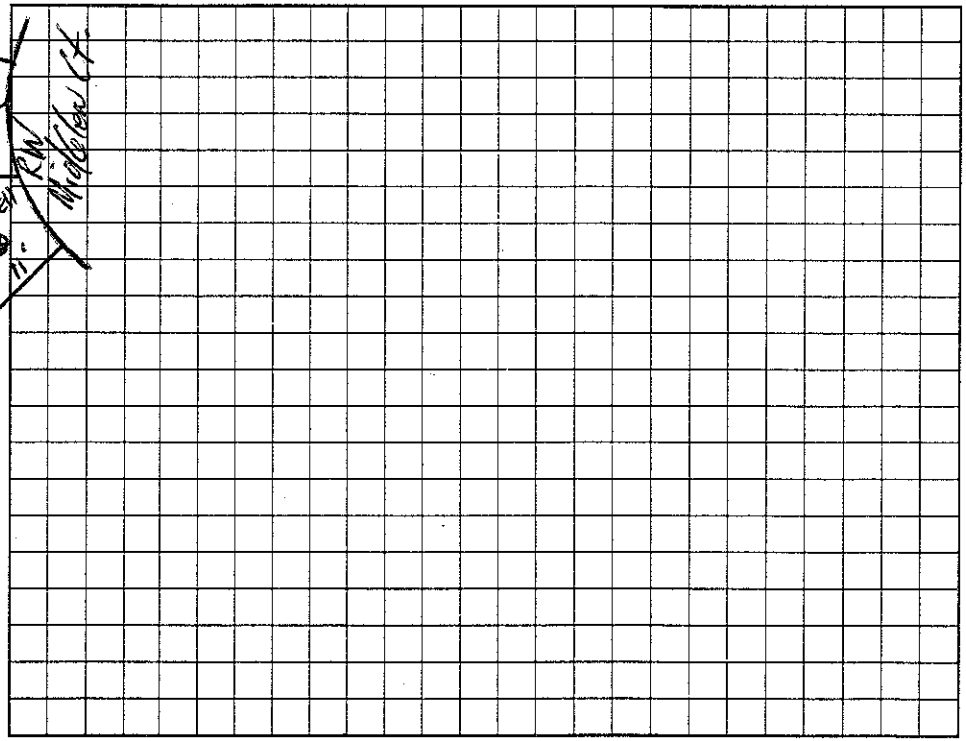

Permit can be suspended or revoked if any false information is supplied toward securing the permit/any unauthorized changes are made to the site/any unauthorized changes are made in the installation of the system. Improvement Permit with plat valid without expiration. Improvement Permit with site plan valid for sixty months. Authorization to Construct is valid for a period equal to that of Improvement Permit – not to exceed sixty months.

Signed: date 8-9-02 Installed by: Willie Christenbury

Improvement Permit by: date 7-31-02 Operation Permit by: date 12/8/03

Authorization to Construct by: date 4/23/03 Existing System Inspection by: date

HEALTH DEPT. COPY: WHITE OWNER COPY (FINAL): YELLOW OWNER COPY (INITIAL): PINK