IREDELL COUNTY HEALTH DEPARTMENT

STATESVILLE 704-878-5305 MOORESVILLE 704-664-5281

IMPROVEMENT PERMIT / AUTHORIZATION TO CONSTRUCT / OPERATION PERMIT / EXISTING SYSTEM INSPECTION

PERMIT# ~~10765~~ / 12823 PIN# ~~4659-92-5352.44~~ 4659918728 DATE July 22, 02

OWNER OR CONTRACTOR RFS Investments / Lyle Calkins PHONE: Business _____ Home _____

ADDRESS 149 Yacht Cove Ln. Mooresville 28117

LOCATION 115-21N TR Shinnville Rd. TL Brookglen Dr. cross creek on Right at first intersection

SUBDIVISION Brookglen BLOCK / SECTION 2 LOT 94 LOT AREA .69Ac SITE CLASS PS DESIGN FLOW 360gpd L.T.A.R. .03

Septic Tank: 1000 Gallons; STB 794 Date 4-20-04

Pump Tank: 1000 Gallons; PT 283 Date 5-24-05

Pump Make: Zoeller Model N152 Serial No. _____

Nitrification Field: No Fields ___ Square Feet 900 Linear Feet 300

No Lines 5@60' Trench Width 36" Max Trench Bottom Depth 36" Gravel Depth NA

☑ New System ☐ Repair System Type: I, II, III, IV, V, VI

System Description: PM - 25% Reduction

Repair System Description: LPPBPS

Maintenance Agreement Required: ☐ Yes ☑ No initially

☑ House/Mod. Home No. Bedrooms 3

☐ Mobile Home No. Bathrooms 2

☐ Business No. Employees ___

☐ Other _____

☐ Slab ☑ Crawl Space ☐ Basement w/plumbing ☐ Basement wo/plumbing

Water Supply: ☑ Individual ☐ Public ☐ Community

Comments:/Conditions:


Remove any old burn barrels in septic system area.

Comments:/Conditions: Installed 3-100" Quick 4 - Pressure Manifold


4/12/06 Met with Bret Nielson (owner) PM (Pressure Manifold) 5Ft From PL.

1"=50'

INITIAL SITE SKETCH

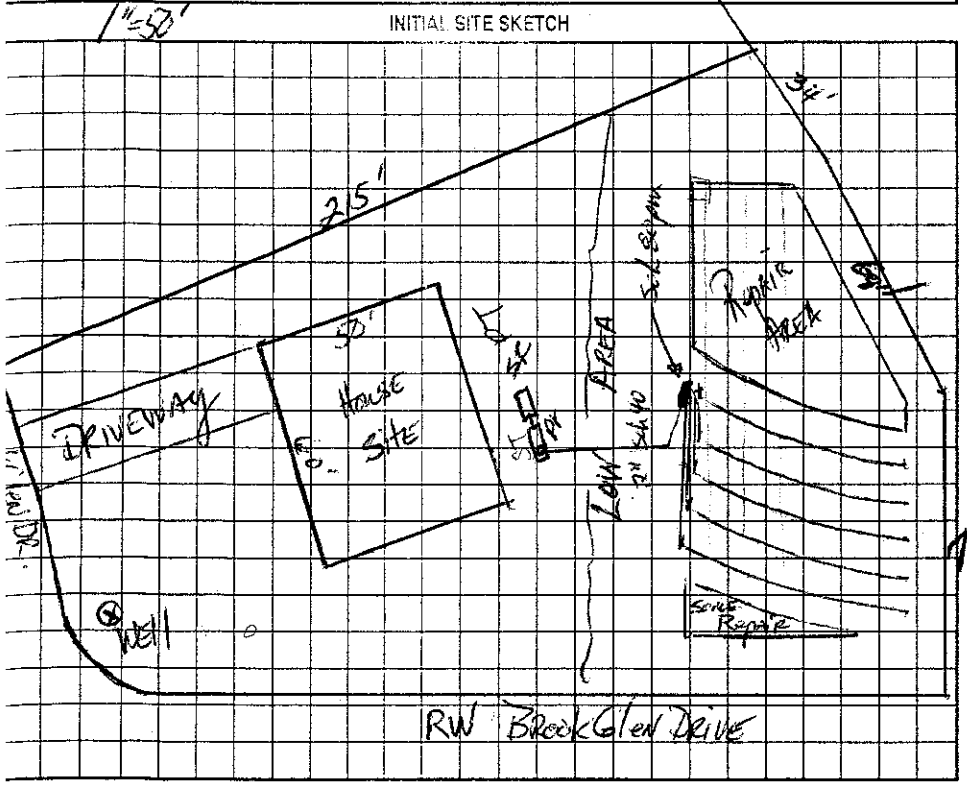

AS BUILT SKETCH

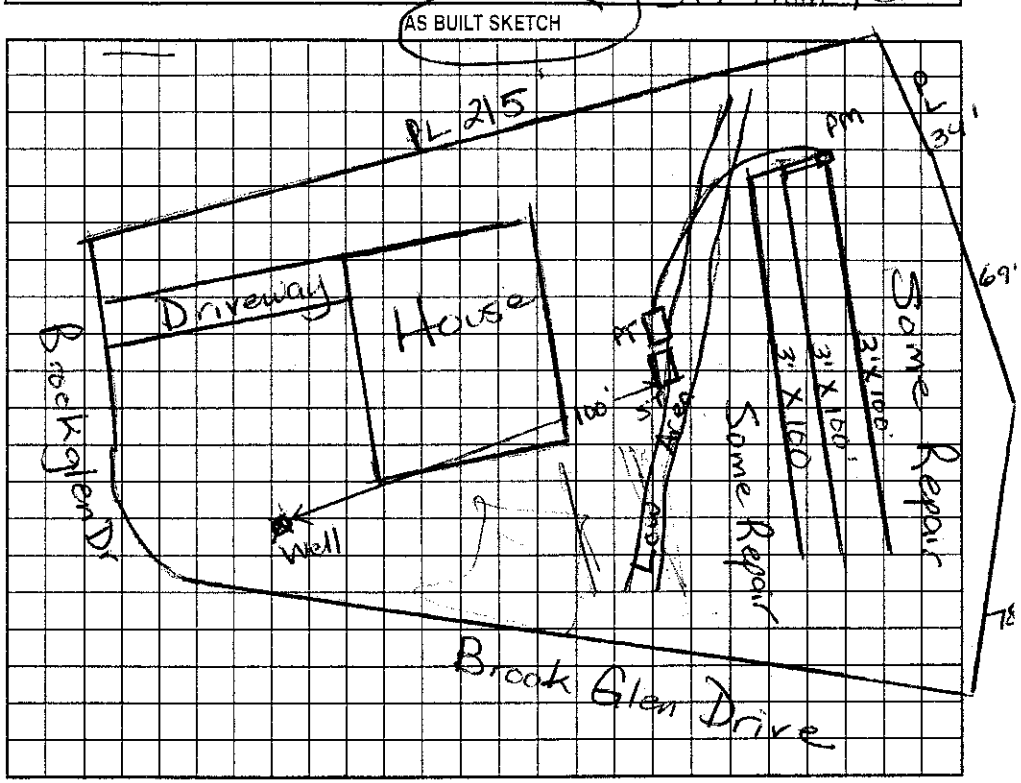

Permit can be suspended or revoked if any false information is supplied toward securing the permit/any unauthorized changes are made to the site/any unauthorized changes are made in the installation of the system. Improvement Permit with plat valid without expiration. Improvement Permit with site plan valid for sixty months. Authorization to Construct is valid for a period equal to that of Improvement Permit – not to exceed sixty months.

Signed: _____ date 8-5-02 Installed by: Willie Chesterbury

Improvement Permit by: _____ date 7-22-02 Operation Permit by: Maiat H Dotson RS date 8/15/05

Authorization to Construct by: _____ RS date 4/19/05 Existing System Inspection by: _____ date _____

HEALTH DEPT. COPY: WHITE OWNER COPY (FINAL): YELLOW OWNER COPY (INITIAL): PINK