11:3

IREDELL COUNTY HEALTH DEPARTMENT

STATESVILLE 704-878-5305 MOORESVILLE 704-664-5291

IMPROVEMENT PERMIT / AUTHORIZATION TO CONSTRUCT / OPERATION PERMIT / EXISTING SYSTEM INSPECTIO

PERMIT# 104376 PIN# 4659-92-5352 .59 4659919268 DATE July 5, 02

OWNER OR CONTRACTOR KFS Investments / Calkins Homes PHONE: Business Home

ADDRESS 149 Yacht Cove Ln. Mooresville NC 28117

LOCATION 115-21 N. TR Shinnville Rd. TL Brookglen Dr. 1st lot on left after crossing creek 207 Brook Glen Dr.

SUBDIVISION Brookglen BLOCK / SECTION 2 LOT 59, 59A LOT AREA 1.18Ac + .38Ac SITE CLASS PS SFE DESIGN FLOW 360gpd L.T.A.R. .3 (59A)

Septic Tank: 1000 Gallons; STB 744 Date 10-14-03 ☑ New System ☐ Repair System Type: I, II, III, IV, V, VI

Pump Tank: 1000 Gallons; PT 27 Date 10-26-03 System Description: PM- 25% Reduction 59A

Pump Make: Zoeller Model N163 Serial No. Repair System Description: LPPBS, SOME LPP Repair

Nitrification Field: No Fields 1 Square Feet 900 Linear Feet 300 Maintenance Agreement Required: ☐ Yes ☑ No

No Lines 3 Trench Width 36" Max Trench Bottom Depth 36" Gravel Depth N/A ☐ Slab ☑ Crawl Space ☐ Basement w/plumbing ☐ Basement wo/plumbing

☑ House/Mod. Home No. Bedrooms 3

☐ Mobile Home No. Bathrooms 2

☐ Business No. Employees


☐ Other

Water Supply: ☑ Individual ☐ Public ☐ Community

Comments:/Conditions:
Remove any old basements/traces in septic system area.
Reviewed site & building plans 10/3/03
Essentially in compliance with LP

Comments:/Conditions: Checked tanks, lines 12/19/03
& pressure
Alarm & Elect.

INITIAL SITE SKETCH

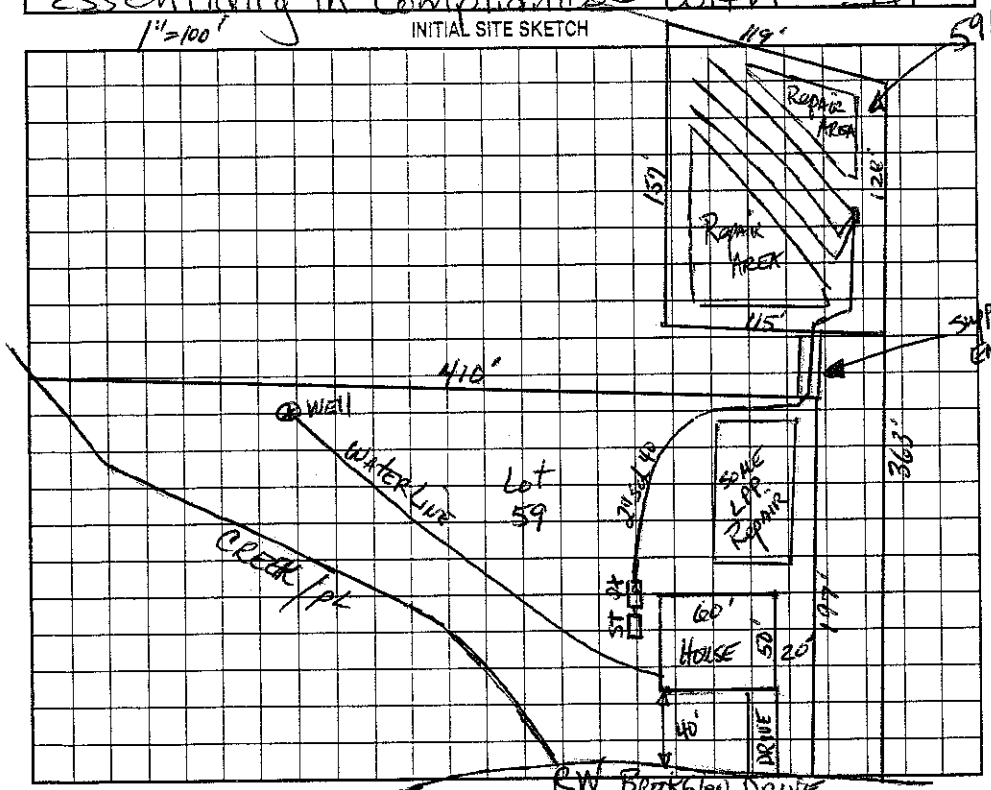

AS BUILT SKETCH

Installed E-Z-Flow as drawn.

Permit can be suspended or revoked if any false information is supplied toward securing the permit/any unauthorized changes are made to the site/any unauthorized changes are made in the installation of the system. Improvement Permit with plat valid without expiration. Improvement Permit with site plan valid for sixty months. Authorization to Construct is valid for a period equal to that of Improvement Permit – not to exceed sixty months.

Signed: date 8-9-02

Improvement Permit by: date 7-5-02

Authorization to Construct by: Maina Dotson RS date 10/3/03

Installed by: Willie Christenbury RS

Operation Permit by: Maina Dotson date 1/6/04

Existing System Inspection by: date

HEALTH DEPT. COPY: WHITE OWNER COPY (FINAL): YELLOW OWNER COPY (INITIAL): PINK