4.00

IREDELL COUNTY HEALTH DEPARTMENT

STATESVILLE 704-878-5305 MOORESVILLE 704-664-5281

IMPROVEMENT PERMIT / AUTHORIZATION TO CONSTRUCT / OPERATION PERMIT / EXISTING SYSTEM INSPECTION

PERMIT# 104631 / 123706 PIN# 4659-92-5352.100 4659-92-2016 DATE July 23, 02

OWNER OR CONTRACTOR KES Investments / Calkins Construct PHONE: Business _____ Home _____

ADDRESS 149 Yacht Cove Ln. Mooresville 28117

LOCATION 115-21 N TR Shinnville Rd. TL Brookglen Dr. cross creek Bear left on Right

SUBDIVISION Brookglen BLOCK / SECTION 2 LOT 100 LOT AREA .90 AC SITE CLASS. PS DESIGN FLOW 360gpd L.T.A.R. e3

Septic Tank: 1000 Gallons; STB 794 Date 9-21-04
Pump Tank: 1000 Gallons; PT 283 Date 9-21-04
Pump Make: Zoeller Model 1/4 HP Serial No. _____
Nitrification Field: No Fields 1 Square Feet 1200 Linear Feet 400
No Lines 4 Trench Width 36" Max Trench Bottom Depth 36" Gravel Depth 12"

☑ New System ☐ Repair System Type: I, II, (III), IV, V, VI
System Description: pm - conventional
Repair System Description: pm - 25% Reduction
Maintenance Agreement Required: ☐ Yes ☑ No


☑ House/Mod. Home No. Bedrooms 3
☐ Mobile Home No. Bathrooms 2
☐ Business No. Employees _____
☐ Other _____
☐ Slab ☑ Crawl Space ☐ Basement w/plumbing ☐ Basement wo/plumbing

Water Supply: ☑ Individual ☐ Public ☐ Community

Comments:/Conditions:

1"=50'

INITIAL SITE SKETCH

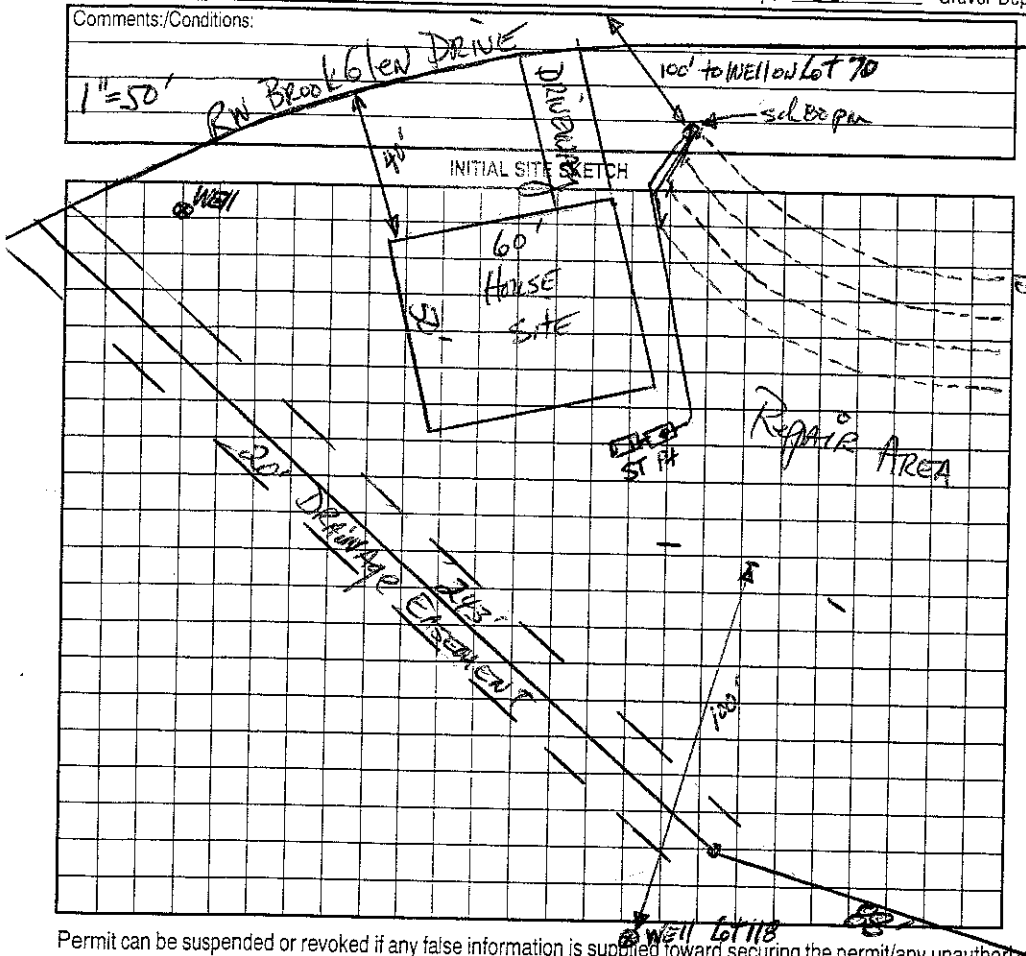

Comments:/Conditions:

Remove any old burn /terraces in septic replacement area.
Reviewed Building plans & essentially in compliance with IP 8/19/04

AS BUILT SKETCH

*Need to check floats

Checked Tanks, lines & pressure 11/2/04

Permit can be suspended or revoked if any false information is supplied toward securing the permit/any unauthorized changes are made to the site/any unauthorized changes are made in the installation of the system. Improvement Permit with plat valid without expiration. Improvement Permit with site plan valid for sixty months. Authorization to Construct is valid for a period equal to that of Improvement Permit – not to exceed sixty months.

Signed: _____ date 8-9-02

Improvement Permit by: _____ date 7-23-02

Authorization to Construct by: _____ date 8/19/04

Installed by: Willie Christianbury

Operation Permit by: _____ date 12/29/04

Existing System Inspection by: _____ date _____

HEALTH DEPT. COPY: WHITE OWNER COPY (FINAL): YELLOW OWNER COPY (INITIAL): PINK