IREDELL COUNTY HEALTH DEPARTMENT

STATESVILLE 704-878-5305 MOORESVILLE 704-664-5281

IMPROVEMENT PERMIT / AUTHORIZATION TO CONSTRUCT / OPERATION PERMIT / EXISTING SYSTEM INSPECTI

PERMIT# 104637 PIN# ~~4659-92-5352, 105~~ 4659-92-2760 DATE July 26, 02

OWNER OR CONTRACTOR KFS Investments PHONE: Business Home

ADDRESS 149 Yacht Cove Ln. Mooresville 28117

LOCATION 115-21 N. TR Statesville Rd TL Brookglen Dr. cross creek Bear right on left

SUBDIVISION Brookglen BLOCK / SECTION 2 LOT 105 LOT AREA .95 AC SITE CLASS. PS DESIGN FLOW 360gpd L.T.A.R. .3

Septic Tank: 1000 Gallons; STB 1012 Date 8/6/02

Pump Tank: Gallons; PT Date

Pump Make: Model Serial No.

Nitrification Field: No Fields 1 Square Feet 1200 Linear Feet 400

No Lines 3 centered Trench Width 36" Max Trench Bottom Depth 36" Gravel Depth 12"

☑ New System ☐ Repair System Type: I (II) III, IV, V, VI

System Description: Gravity Conventional

Repair System Description: Gravity 25% Reduction

Maintenance Agreement Required: ☐ Yes ☑ No

☑ House/Mod. Home No. Bedrooms 3

☐ Mobile Home No. Bathrooms 2

☐ Business No. Employees


☐ Other

☐ Slab ☑ Crawl Space ☐ Basement w/plumbing ☐ Basement wo/plumbing

Water Supply: ☑ Individual ☐ Public ☐ Community


Comments/Conditions: Remove any old berms terraces in septic system area.

INITIAL SITE SKETCH 1"=50'

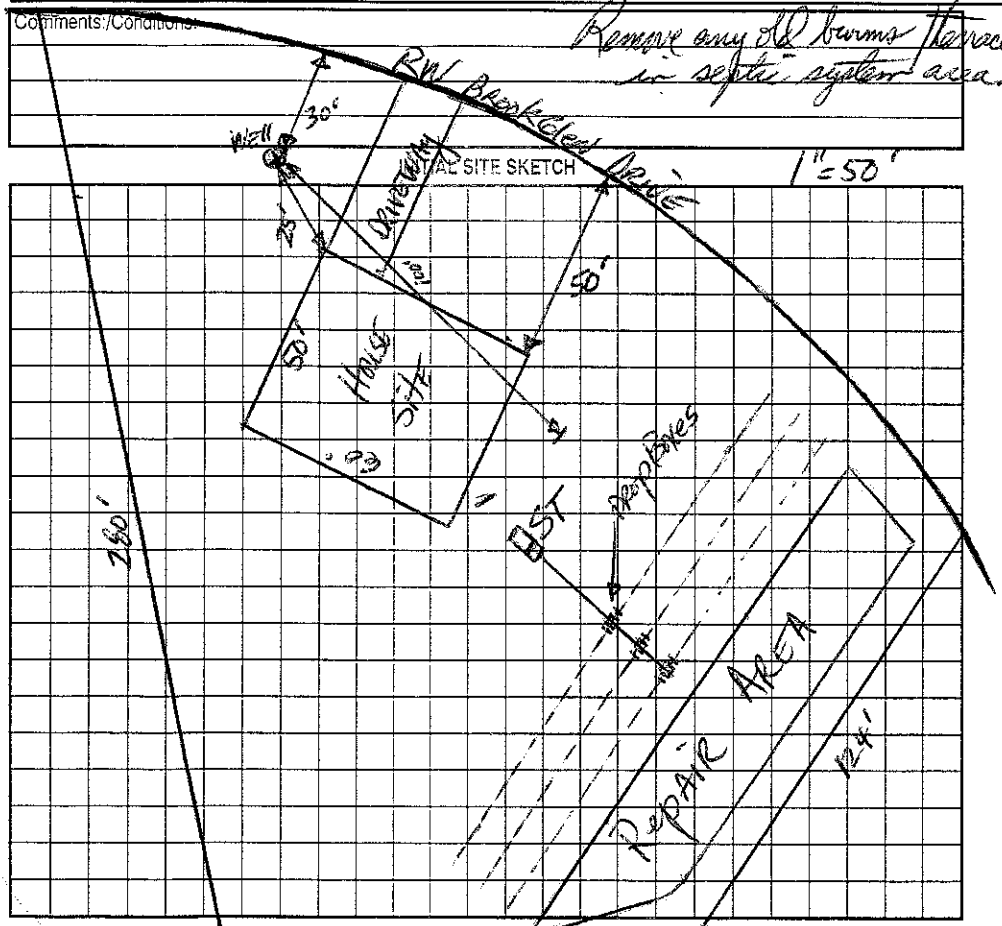

Comments/Conditions: Note: Driveway will be for side load garage. Move well slightly over. Reviewed plans essentially in compliance with permit.

AS BUILT SKETCH

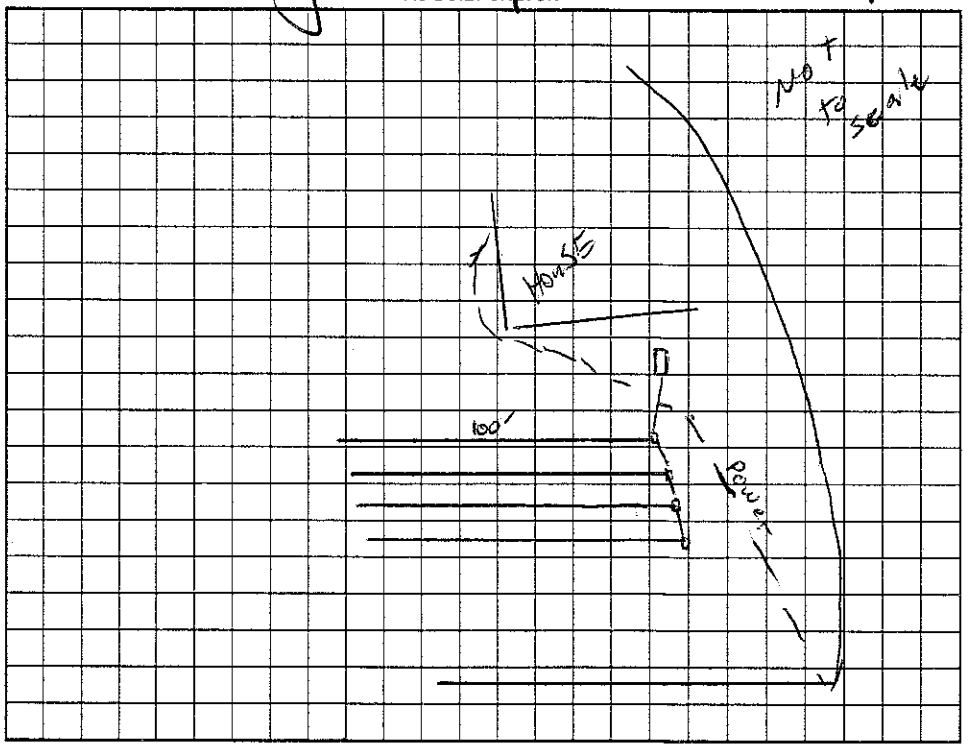

Permit can be suspended or revoked if any false information is supplied toward securing the permit/any unauthorized changes are made to the site/any unauthorized changes are made in the installation of the system. Improvement Permit with plat valid without expiration. Improvement Permit with site plan valid for sixty months. Authorization to Construct is valid for a period equal to that of Improvement Permit – not to exceed sixty months.

Signed: date 8-9-02 Installed by: Tommy Faye

Improvement Permit by: RS date 7-26-02 Operation Permit by: RS date 2/13/03

Authorization to Construct by: RS date 11-7-02 Existing System Inspection by: date

HEALTH DEPT. COPY: WHITE OWNER COPY (FINAL): YELLOW OWNER COPY (INITIAL): PINK