IREDELL COUNTY HEALTH DEPARTMENT

STATESVILLE 704-878-5305 MOORESVILLE 704-664-5281

IMPROVEMENT PERMIT / AUTHORIZATION TO CONSTRUCT / OPERATION PERMIT / EXISTING SYSTEM INSPECTION

PERMIT# 104656 PIN# ~~4659-92-5352-116~~ 4659-92-4051 DATE July 30, 02

OWNER OR CONTRACTOR KFS Investments // ES Johnson Bldrs. PHONE: Business _____ Home _____

ADDRESS 149 Yacht Cove Lane Mooresville 28117

LOCATION 115-21N TR Shinnville Rd. TL Brookglen Dr. cross creek Bear Right TL Middleton Ct. at end

SUBDIVISION Brookglen BLOCK / SECTION 2 LOT 116 LOT AREA .72 ac SITE CLASS PS DESIGN FLOW 360gpd L.T.A.R. .3

Septic Tank: 1000 Gallons; STB 1012 Date 8-11-02

Pump Tank: _____ Gallons; PT _____ Date _____

Pump Make: _____ Model _____ Serial No. _____

Nitrification Field: No Fields 2 Square Feet 900 Linear Feet 300

No Lines 3+3 Trench Width 36" Max Trench Bottom Depth 36 Gravel Depth NA

☑ New System ☐ Repair System Type: I. II. III. IV. V. VI.

System Description: *Gravity 25% Reduction

Repair System Description: 2 PPP BPS

Maintenance Agreement Required: ☐ Yes ☑ No Initially

☑ House/Mod. Home No. Bedrooms 3

☐ Mobile Home No. Bathrooms 2

☐ Business No. Employees _____

☐ Other _____

☐ Slab ☑ Crawl Space ☐ Basement w/plumbing ☐ Basement wo/plumbing

Water Supply: ☑ Individual ☐ Public ☐ Community


Comments:/Conditions:

Use Flow Divider to 2 D-Boxes with Leveters.

Remove any old burens in septic system area. Do not cut House Site. *Build high crawl space. Exit plumbing where shown within 6" of existing grade.

INITIAL SITE SKETCH

1"=50'

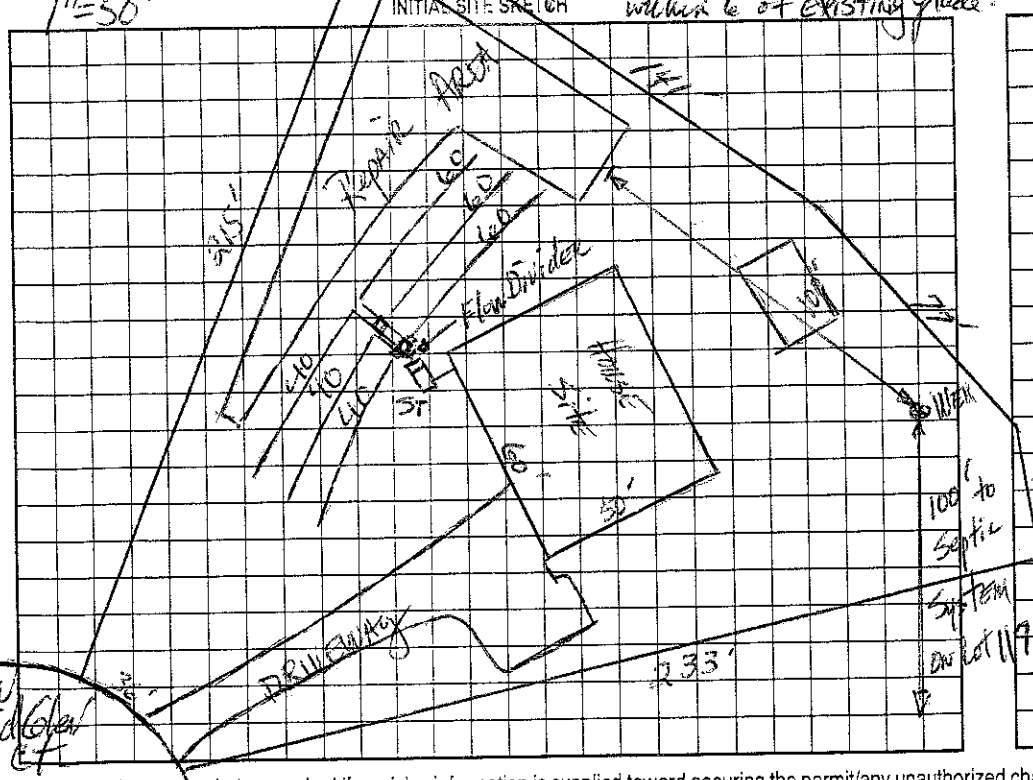


Comments:/Conditions: Yellow Filter installed

ST marker in place (2 lines)

Distribution to 1st D-box (as Drop box) then over flow to 2nd D-box (4 lines)

AS BUILT SKETCH

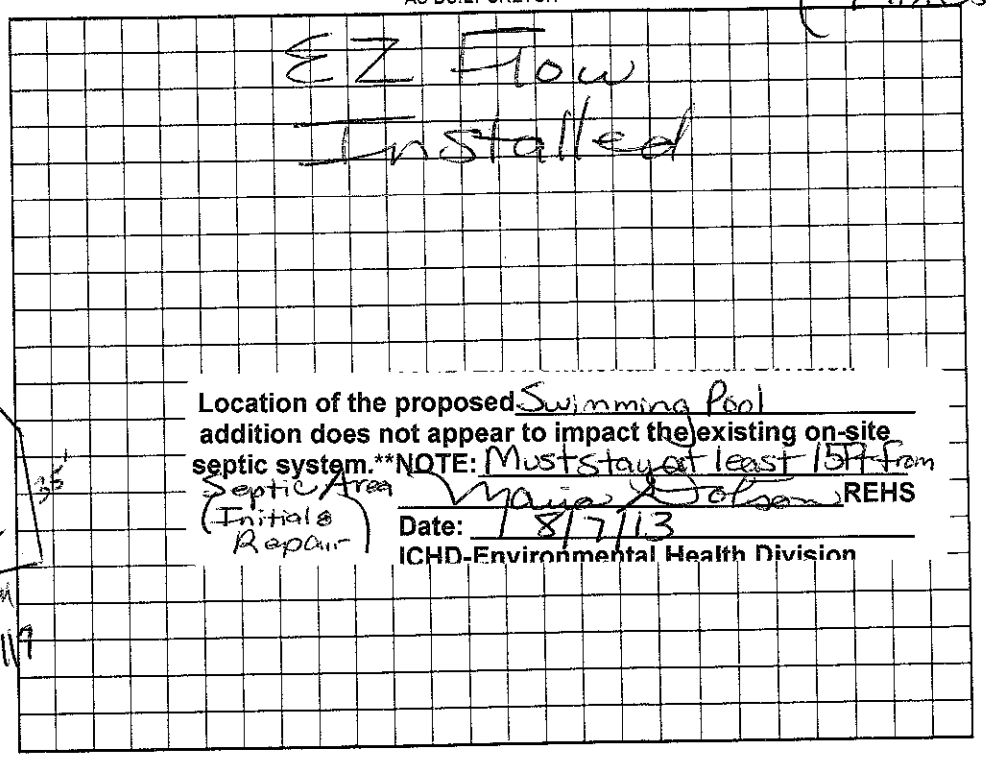

Location of the proposed Swimming Pool **addition does not appear to impact the existing on-site septic system.** **NOTE:** Must stay at least 15ft from Septic Area (Initial & Repair)

Major Johnson REHS

Date: 8/7/13

ICHD-Environmental Health Division

Permit can be suspended or revoked if any false information is supplied toward securing the permit/any unauthorized changes are made to the site/any unauthorized changes are made in the installation of the system. Improvement Permit with plat valid without expiration. Improvement Permit with site plan valid for sixty months. Authorization to Construct is valid for a period equal to that of Improvement Permit – not to exceed sixty months.

Signed: _____ date 8-9-02 Installed by: Tommy Frye R.S.

Improvement Permit by: _____ date 7-30-02 Operation Permit by: Major H. Johnson date 3/28/03

Authorization to Construct by: _____ date 12-30-02 Existing System Inspection by: _____ date _____

HEALTH DEPT. COPY: WHITE OWNER COPY (FINAL): YELLOW OWNER COPY (INITIAL): PINK