IREDELL COUNTY HEALTH DEPARTMENT

STATESVILLE 704-878-5305 MOORESVILLE 704-664-5281

IMPROVEMENT PERMIT / AUTHORIZATION TO CONSTRUCT / OPERATION PERMIT / EXISTING SYSTEM INSPECTION

PERMIT# 104656 PIN# ~~4659-92-5352 .116~~ 4659-92-4051 DATE July 30, 02

OWNER OR CONTRACTOR KFS Investments // ES Johnson Bldrs. PHONE: Business _____ Home _____

ADDRESS 149 Yacht Cove Lane Mooresville 28117

LOCATION 115-21N TR Shumaville Rd. TR Brookglen Dr. cross creek Bear Right TR Middlen Ct. at end

SUBDIVISION Brook Glen BLOCK / SECTION 5 LOT 118 LOT AREA .72 ac SITE CLASS PS DESIGN FLOW 360gpd L.T.A.R. .3

Septic Tank: 1000 Gallons; STB 1012 Date 8-11-02
Pump Tank: _____ Gallons; PT _____ Date _____
Pump Make: _____ Model _____ Serial No. _____
Nitrification Field: No Fields 2 Square Feet 900 Linear Feet 300
No Lines 3+3 Trench Width 36" Max Trench Bottom Depth 36"


☑ New System ☐ Repair System Type: I, II, III, IV, V, VI
System Description: *Gravity 25% Reduction
Repair System Description: 2 PPP BPS
Maintenance Agreement Required: ☐ Yes ☑ No Initially
Gravel Depth NA ☐ Slab ☑ Crawl Space ☐ Basement w/plumbing ☐ Basement wo/plumbing

☑ House/Mod. Home No. Bedrooms 3
☐ Mobile Home No. Bathrooms 2
☐ Business No. Employees ____
☐ Other _____

Water Supply: ☑ Individual ☐ Public ☐ Community


Comments:/Conditions:
Use Flow Dividere to 2 D-Boxes with Levelers.
1"=50'
Remove any old burens in septic system area. Do not cut house site. *Build high crawl space. Exit plumbing where shown within 6" of existing grade.

INITIAL SITE SKETCH

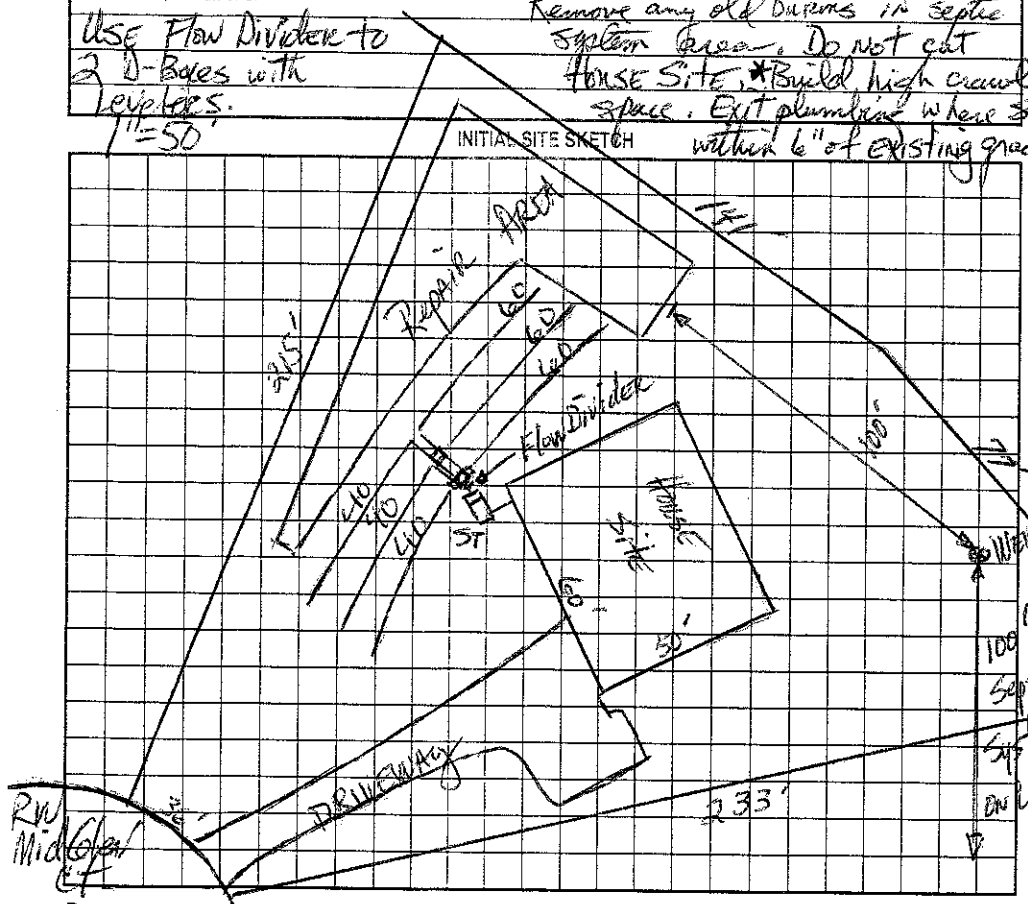

Comments:/Conditions: Yellow Filter installed
ST marker in place (2 lines)
Distribution to 1st D-box (as Drop box) then overflow to 2nd D-box (4 lines)

AS BUILT SKETCH

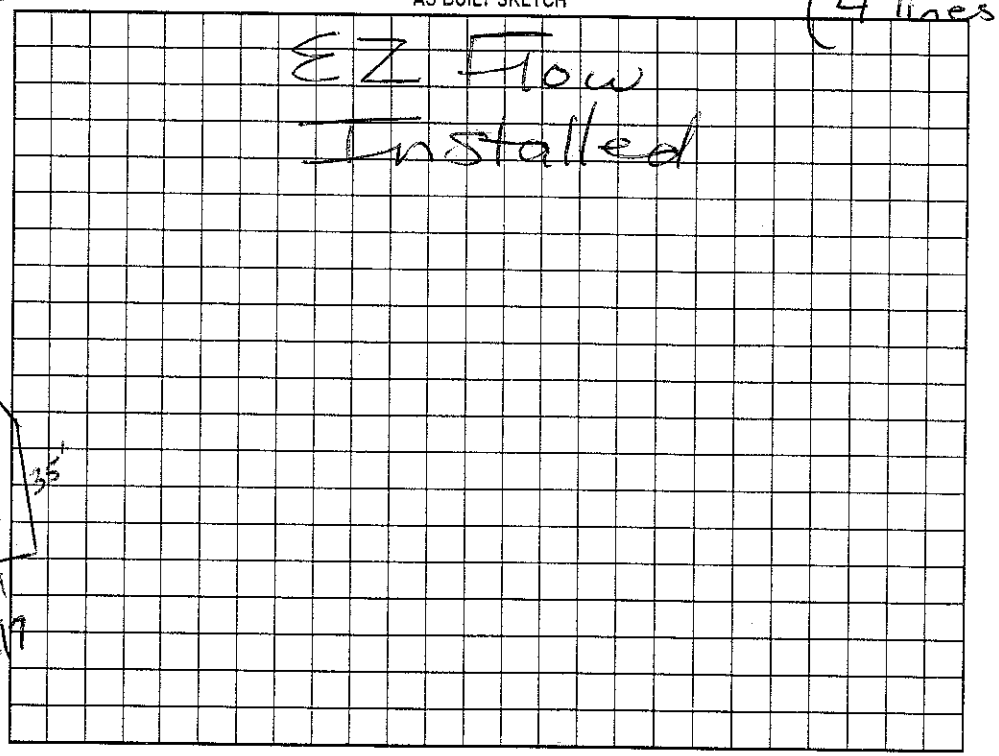

Permit can be suspended or revoked if any false information is supplied toward securing the permit/any unauthorized changes are made to the site/any unauthorized changes are made in the installation of the system. Improvement Permit with plat valid without expiration. Improvement Permit with site plan valid for sixty months. Authorization to Construct is valid for a period equal to that of Improvement Permit – not to exceed sixty months.

_____ date 8-9-02 Installed by: Tommy Frye RS

_____ date 7-30-02 Operation Permit by: _____ date 3/28/03

_____ date 12-30-02 Existing System Inspection by: _____ date _____

DEPT. COPY: WHITE OWNER COPY (FINAL): YELLOW OWNER COPY (INITIAL): PINK