Existing System / Pool mes Ø

IREDELL COUNTY HEALTH DEPARTMENT

STATESVILLE 704-878-5305 MOORESVILLE 704-664-5281

IMPROVEMENT PERMIT / AUTHORIZATION TO CONSTRUCT / OPERATION PERMIT / EXISTING SYSTEM INSPECTION

PERMIT # 156407 PIN # 4659926770.000 DATE 5/7/09

OWNER or APPLICANT Victor S. & Julie A. Pille PHONE: Business 704 799-3191 Home: 704 658-8008

OWNER or APPLICANT ADDRESS 344 Brook Glen Dr.

LOCATION / DIRECTIONS Hwy 21 N TR Shinnville Rd. TL BrookGlen Bear right on BrookGlen on Left.

SUBDIVISION BrookGlen BLOCK / SECTION LOT # 107 LOT AREA 1.29ac DESIGN FLOW 480 L.T.A.R. .25

Septic Tank Exis 1000 Gallons: STB Date

Pump Tank Exis 1000 Gallons: P T Date

Pump Make Model Serial #

Nitrification Field No Fields 1 No Lines 7 Linear Feet Exis 490'

Trench Width 36" Max. Trench Bottom Depth 36" Gravel Depth N/A

☐ New System ☐ Repair ☐ Expansion System Type I II III IV V VI

System Description: Existing System

Repair System Description:

Maintenance Agreement Required ☐ YES ☐ NO

☐ GRAVITY ☑ PRESSURE

☑ Residence No. Bedrooms 4

☐ Business No. Persons

☐ Other No. Employees

☐ Slab ☑ Crawl Space

☐ Basement w/plumbing ☐ Basement w/o plumbing


Water Supply ☑ Private Exis ☐ Public ☐ Community

Comments / Conditions


Comments / Conditions Existing pool does not affect existing septic system or repair area.

1" = 50'

INITIAL SITE SKETCH

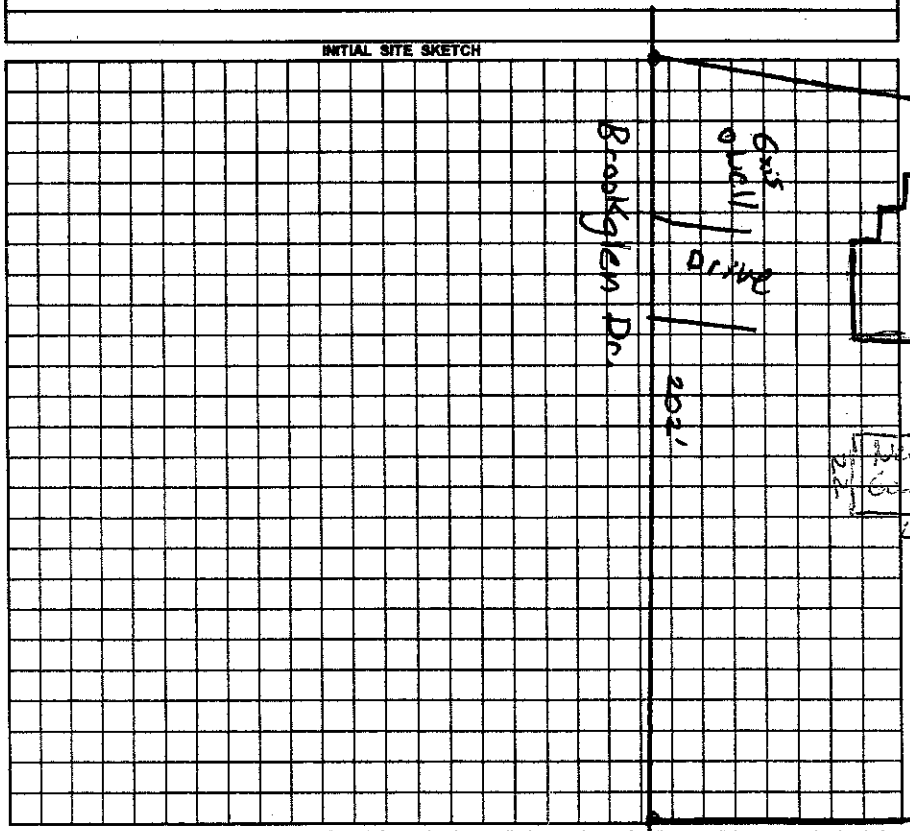

AS BUILT SKETCH

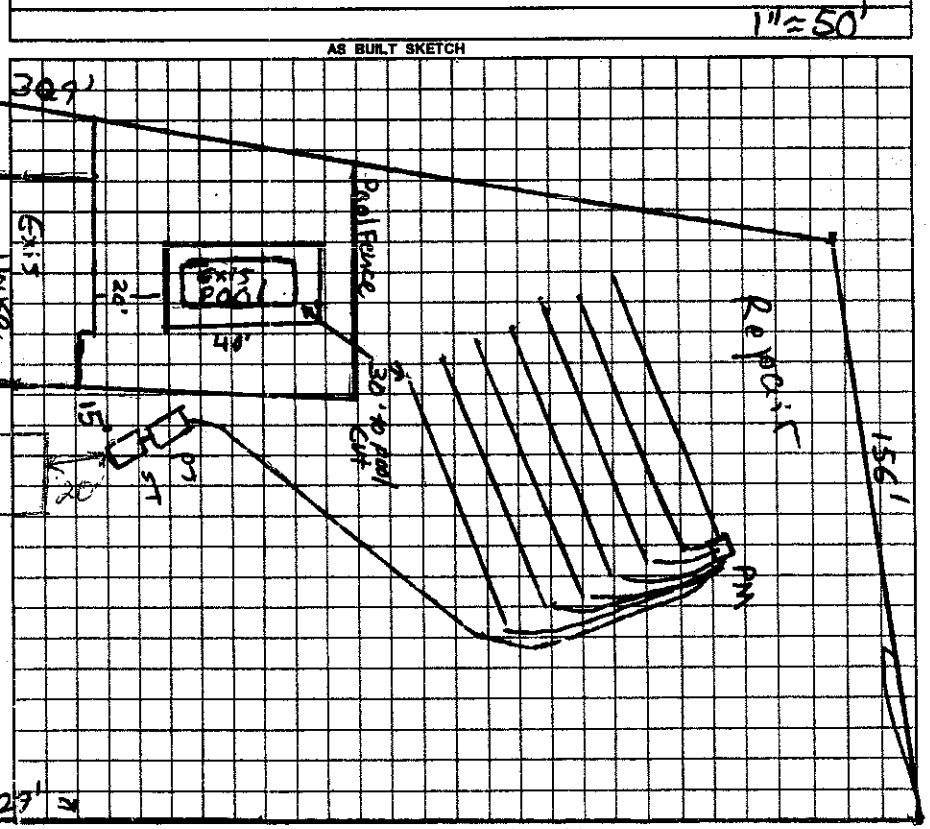

Permit can be suspended or revoked if any false information is supplied toward securing the permit / any unauthorized changes are made to the site / any unauthorized changes are made in the installation of the system.

☐ *IMPROVEMENT PERMIT w / plat valid without expiration.* ☐ *IMPROVEMENT PERMIT w / site plan valid for 60 mos.* ☐ *AUTHORIZATION TO CONSTRUCT valid for period equal to IMPROVEMENT PERMIT-not to exceed 60 mo.*

Owner / Applicant Signature Julie Pille Date 5-7-09

Improvement Permit by: Date

Authorzation to Construct by: Date

Installed by:

Operation Permit by: Date:

Existing System Inspected by Anthony Cobert Jr. R.S. Date: 5/7/09

YOU SHOULD CONTACT A LOCATOR SERVICE PRIOR TO ANY EXCAVATION.

WHITE COPY Environmental Health YELLOW COPY (Final) Owner / Applicant PINK COPY (Initial) Owner / Applicant