# IREDELL COUNTY HEALTH DEPARTMENT

STATESVILLE 704-878-5305 MOORESVILLE 704-664-5281

## IMPROVEMENT PERMIT / AUTHORIZATION TO CONSTRUCT / OPERATION PERMIT / EXISTING SYSTEM INSPECTION

PERMIT# 104652 PIN# 4659 92 5352 . 114 4659-92-7222 DATE 8/23/04

OWNER OR CONTRACTOR E S JOHNSON BLDRS. PHONE: Business 704-799-2976 Home

ADDRESS PO Box 1402 CORNELIUS, NC 28031

LOCATION I15-21N TR Shinnville Rd. TL Brookglen Dr. X creek bear (R) TL Mid Glen Ct. on (R)

SUBDIVISION Brookglen BLOCK / SECTION 2 LOT 114 LOT AREA .54AC SITE CLASS PS DESIGN FLOW 360 L.T.A.R. .25-.3

Septic Tank: 1000 Gallons; STB 794 Date 8-9-04
Pump Tank: 1000 Gallons; PT 283 Date 6-8-04
Pump Make: Zoeller Model 153 Serial No.
Nitrification Field: No Fields 1 Square Feet 960 Linear Feet 320
No Lines 4@ 80' Trench Width 3 Max Trench Bottom Depth 36" X Gravel Depth N/A

☒ New System ☐ Repair System Type: I, II, III, IV, V, VI
System Description: Pres Man – 25% Reduced
Repair System Description: None
Maintenance Agreement Required: ☐ Yes ☒ No


☒ House/Mod. Home No. Bedrooms 3
☐ Mobile Home No. Bathrooms 3
☐ Business No. Employees
☐ Other
☐ Slab ☒ Crawl Space ☐ Basement w/plumbing ☐ Basement wo/plumbing

Water Supply: ☒ Individual ☐ Public ☐ Community

Comments/Conditions: X Install trenches at 36" trench bottom. Plumbing exited on lower side of house which necessitated pumping

Comments/Conditions Checked all tanks, lines & pressure 9/13/04

INITIAL SITE SKETCH

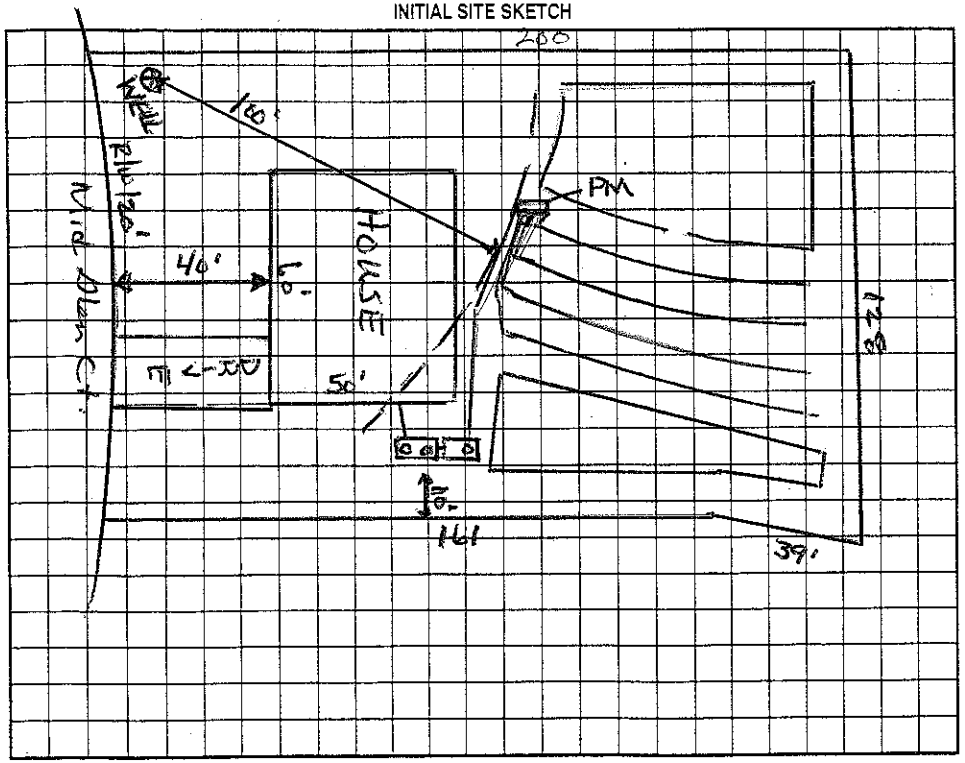


AS BUILT SKETCH

Installed EZ Flow for Drainfield.

Permit can be suspended or revoked if any false information is supplied toward securing the permit/any unauthorized changes are made to the site/any unauthorized changes are made in the installation of the system. Improvement Permit with plat valid without expiration. Improvement Permit with site plan valid for sixty months. Authorization to Construct is valid for a period equal to that of Improvement Permit – not to exceed sixty months.

Signed: [signature] date

Improvement Permit by: Wesley Sparks R.S. date 8/23/04

Authorization to Construct by: Wesley Sparks R.S. date 8/23/04

Installed by: Willie Christenbury

Operation Permit by: [signature] RS date 10/11/04

Existing System Inspection by: date

HEALTH DEPT. COPY: WHITE OWNER COPY (FINAL): YELLOW OWNER COPY (INITIAL): PINK