L230-1100

IREDELL COUNTY HEALTH DEPARTMENT

STATESVILLE 704-878-5305 MOORESVILLE 704-664-5281

IMPROVEMENT PERMIT / AUTHORIZATION TO CONSTRUCT / OPERATION PERMIT / EXISTING SYSTEM INSPECTION

PERMIT# 104651 PIN# 4659-92-5352 Lot 113 4659-92-8271 DATE July 29, 02

OWNER OR CONTRACTOR KES Investments // ES Johnson Builders PHONE: Business Home

ADDRESS 149 Yacht Cove Ln. Mooresville 28117

LOCATION I-77 115-21N. TR Shinnville Rd. TL Brookglen Dr. crosswalks Box Right on left

SUBDIVISION Brookglen BLOCK / SECTION 2 LOT 113 LOT AREA .59ac SITE CLASS. PS DESIGN FLOW 360gpd L.T.A.R. .25

Septic Tank: 1000 Gallons; STB 794 Date 11-5-03
Pump Tank: 1000 Gallons; PT 27 Date 5-18-03
Pump Make: Zoeller Model 153 Serial No.
Nitrification Field: No Fields 1 Square Feet 1080 Linear Feet 360
No Lines 4 Trench Width 36" Trench Bottom Depth 36" Gravel Depth

☑ New System ☐ Repair System Type: I. II. III. IV. V. VI
System Description: PM - 35% Reduction
Repair System Description: LPPBPS
Maintenance Agreement Required: ☐ Yes ☑ No initially

☑ House/Mod. Home No. Bedrooms 3
☐ Mobile Home No. Bathrooms 2
☐ Business No. Employees
☐ Other
☐ Slab ☑ Crawl Space ☐ Basement w/plumbing ☐ Basement wo/plumbing


Water Supply: ☐ Individual ☐ Public ☐ Community

Comments:/Conditions:
Remove any old wiring/tracer in septic system area
* Install 1 Laterals at 36" Trench bottom depth.

Comments:/Conditions: Checked tanks, elect. & alarm
1/13/04

INITIAL SITE SKETCH

1"=50'

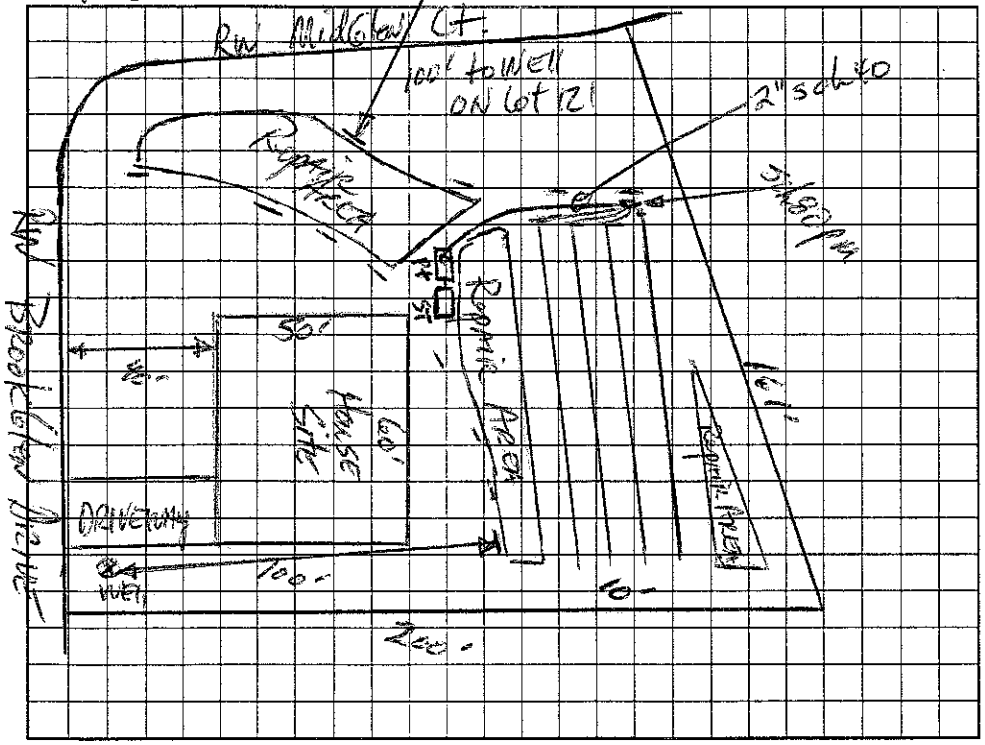

AS BUILT SKETCH

Installed EZ-flow Drainfield as Drawn

Permit can be suspended or revoked if any false information is supplied toward securing the permit/any unauthorized changes are made to the site/any unauthorized changes are made in the installation of the system. Improvement Permit with plat valid without expiration. Improvement Permit with site plan valid for sixty months. Authorization to Construct is valid for a period equal to that of Improvement Permit – not to exceed sixty months.

Signed: date 8-5-02 Installed by: Willie Christenbury

Improvement Permit by: date 7-29-02 Operation Permit by: RS date 2/6/04

Authorization to Construct by: date 9-5-03 Existing System Inspection by date

HEALTH DEPT. COPY: WHITE OWNER COPY (FINAL): YELLOW OWNER COPY (INITIAL): PINK