Lino 363-01

IREDELL COUNTY HEALTH DEPARTMENT

STATESVILLE 704-878-5305 MOORESVILLE 704-664-5281

IMPROVEMENT PERMIT / AUTHORIZATION TO CONSTRUCT / OPERATION PERMIT / EXISTING SYSTEM INSPECT

PERMIT# 104650 PIN# ~~4659-92-5352.112~~ 4659928385 DATE July 29, 02

OWNER OR CONTRACTOR KFS Investments / Collins PHONE: Business _____ Home _____

ADDRESS 144 Yacht Cove W. Mooresville 28117

LOCATION 115-21N. TR Statesville Rd. TL Brookglen Dr. over creek Bear Right on left

SUBDIVISION Brookglen BLOCK / SECTION 2 LOT 112 LOT AREA .57Ac SITE CLASS. PS DESIGN FLOW 360gpd L.T.A.R. .3

Septic Tank: 1000 Gallons; STB 312 Date 5-14-05
Pump Tank: 1000 Gallons; PT 27 Date 5-28-05
Pump Make: Zoeller Model M152 Serial No. _____
Nitrification Field: No Fields 1 Square Feet 1200 Linear Feet 400
No Lines 4 Trench Width 36" Max Trench Bottom Depth 36" Gravel Depth 12"

☑ New System ☐ Repair System Type: I, II, III, IV, V
System Description: PM- Conventional
Repair System Description: PM- conv. on 25% Rep.
Maintenance Agreement Required: ☐ Yes ☑ No

☑ House/Mod. Home No. Bedrooms 3
☐ Mobile Home No. Bathrooms 2
☐ Business No. Employees _____
☐ Other _____


☐ Slab ☑ Crawl Space ☐ Basement w/plumbing ☐ Basement wo/plumbing

Water Supply: ☑ Individual ☐ Public ☐ Community

Comments:/Conditions:
Remove any old lumber / concrete in septic system area.

Comments:/Conditions: Reviewed site plan & Floor plan 3/22/05, in compliance with original permit. Tanks & lines Checked 7/5/05

1"=50' INITIAL SITE SKETCH

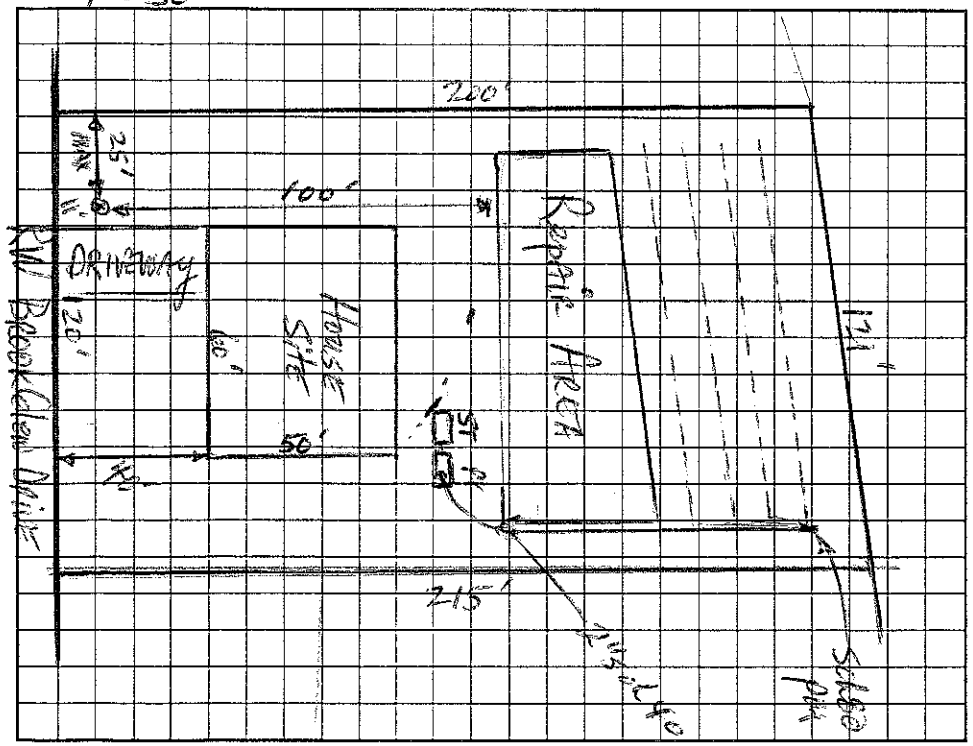

AS BUILT SKETCH

Pump — Quick 4

Permit can be suspended or revoked if any false information is supplied toward securing the permit/any unauthorized changes are made to the site/any unauthorized changes are made in the installation of the system. Improvement Permit with plat valid without expiration. Improvement Permit with site plan valid for sixty months. Authorization to Construct is valid for a period equal to that of Improvement Permit – not to exceed sixty months.

Signed: _____ date 8-9-02 Installed by: Willie Christenbury

Improvement Permit by: _____ RS date 7-29-02 Operation Permit by: _____ date 8/10/05

Authorization to Construct by: _____ RS date 3/22/05 Existing System Inspection by: _____ date _____

HEALTH DEPT. COPY: WHITE OWNER COPY (FINAL): YELLOW OWNER COPY (INITIAL): PINK